IREDELL COUNTY HEALTH DEPARTMENT

STATESVILLE 704-878-5305 MOORESVILLE 704-664-5281

IMPROVEMENT PERMIT / AUTHORIZATION TO CONSTRUCT / OPERATION PERMIT / EXISTING SYSTEM INSPECTION

PERMIT# 1620800/92291 PIN# 4741400933 DATE 9/15/00

OWNER OR CONTRACTOR Len Begler PHONE: Business 662-6400 Home

ADDRESS PO Box 3398 Mooresville NC 28117

LOCATION 21 S, R Byers, on Lt

SUBDIVISION Jacob's Woods BLOCK / SECTION — LOT 7 LOT AREA .52 SITE CLASS P5 DESIGN FLOW 360 L.T.A.R. 0.5

Septic Tank: 1000 Gallons; STB 1012 Date 9-18-2000
Pump Tank: ____ Gallons; PT ____ Date ____
Pump Make: ____ Model ____ Serial No. ____
Nitrification Field: No Fields 1 Square Feet 1200 Linear Feet 400
No Lines 5@80' Trench Width 36" Max Trench Bottom Depth 36"

[X] New System [ ] Repair System Type: I II III IV V VI
System Description: Gravity Conv.
Repair System Description: Grav. 25% Red.
Maintenance Agreement Required: [ ] Yes [X] No

[X] House/Mod. Home No. Bedrooms 3
[ ] Mobile Home No. Bathrooms 2
[ ] Business No. Employees ____
[ ] Other ____


[ ] Slab [X] Crawl Space [ ] Basement w/plumbing [ ] Basement wo/plumbing

Water Supply: [X] Individual [ ] Public [ ] Community


Comments/Conditions: Keep Well 100' from septic System.

Comments/Conditions: ① INSTALLED ROCKLOK FILTER ② INSTALLED WITH MARKER

INITIAL SITE SKETCH

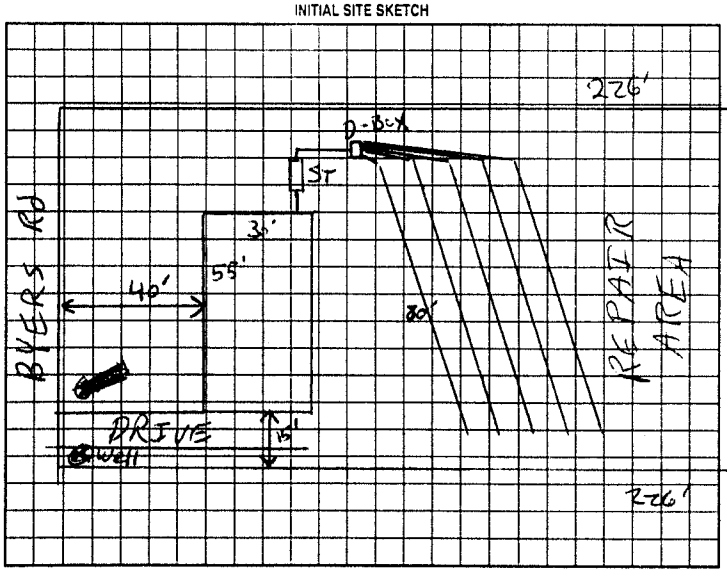

AS BUILT SKETCH

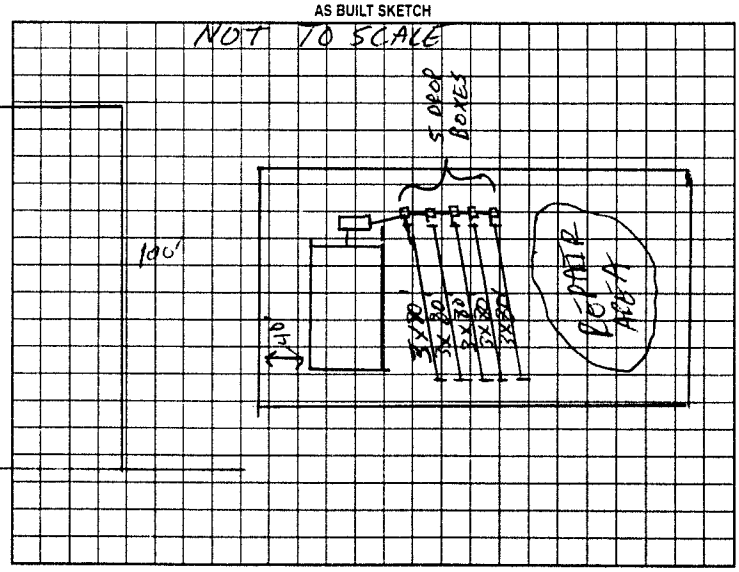

Permit can be suspended or revoked if any false information is supplied toward securing the permit/any unauthorized changes are made to the site/any unauthorized changes are made in the installation of the system. Improvement Permit with plat valid without expiration. Improvement Permit with site plan valid for sixty months. Authorization to Construct is valid for a period equal to that of Improvement Permit – not to exceed sixty months.

Signed: ____ date 9/18/00 Installed by: STEVE JORDAN

Improvement Permit by: ____ LSI date 9/13/00 Operation Permit by: ____ LSI date 01-26-01

Authorization to Construct by: ____ LSI date 9/13/00 Existing System Inspection by: ____ date ____

HEALTH DEPT. COPY: WHITE OWNER COPY (FINAL): YELLOW OWNER COPY (INITIAL): PINK