IREDELL COUNTY HEALTH DEPARTMENT

STATESVILLE 704-878-5305 MOORESVILLE 704-664-5281

Existing System

IMPROVEMENT PERMIT / AUTHORIZATION TO CONSTRUCT / OPERATION PERMIT / EXISTING SYSTEM INSPECTION

PERMIT# 420200 PIN# DATE March 20 2000

OWNER OR CONTRACTOR Kelly CARRIGAN PHONE: Business Home 528-5316

ADDRESS 132 CARRIGAN RD TROUTMAN NC

LOCATION 5th R CARRIGAN RD Tahoe 1st MH on Left #131 Tahoe Lane

SUBDIVISION BLOCK / SECTION LOT LOT AREA SITE CLASS DESIGN FLOW 2K L.T.A.R.

Septic Tank: Existing Gallons: STB Date

Pump Tank: Gallons: PT Date

Pump Make: Model Serial No.

Nitrification Field: No Fields Square Feet Linear Feet

No Lines Trench Width Max Trench Bottom Depth Gravel Depth

☐ New System ☐ Repair System Type: ☐ I ☐ III, IV, V, VI

System Description: Gravel/Bed

Repair System Description:

Maintenance Agreement Required: ☐ Yes ☒ No

☐ Slab ☒ Crawl Space ☐ Basement w/plumbing ☐ Basement wo/plumbing

☐ House/Mod. Home No. Bedrooms 2

☒ Mobile Home No. Bathrooms

☐ Business No. Employees

☐ Other


Water Supply: ☒ Individual ☐ Public ☐ Community WELL

Comments/Conditions:

Comments/Conditions: (1) Remove Addition off Septic TANK (2) Driving + PARKing over System + TANK should stop (3) All plumbing Tied into Septic system.

INITIAL SITE SKETCH

AS BUILT SKETCH

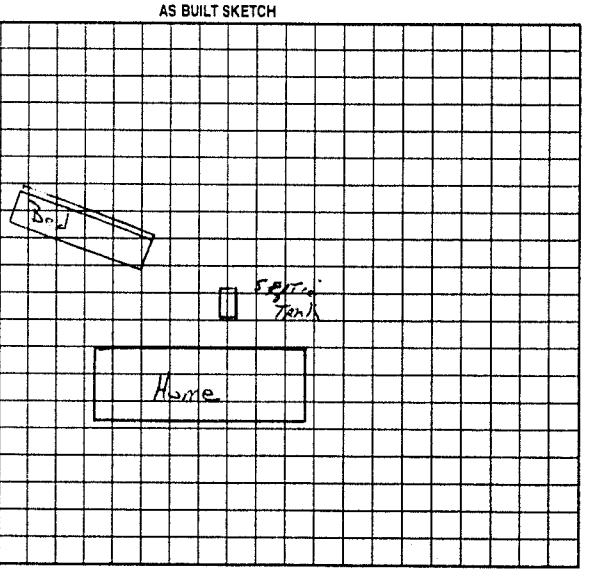

Permit can be suspended or revoked if any false information is supplied toward securing the permit/any unauthorized changes are made to the site/any unauthorized changes are made in the installation of the system. Improvement Permit with plat valid without expiration. Improvement Permit with site plan valid for sixty months. Authorization to Construct is valid for a period equal to that of Improvement Permit – not to exceed sixty months.

Signed: date Installed by:

Improvement Permit by: date Operation Permit by: date

Authorization to Construct by: date Existing System Inspection by: L. Potter date March 20 2000

HEALTH DEPT. COPY: WHITE OWNER COPY (FINAL): YELLOW OWNER COPY (INITIAL): PINK