IREDELL COUNTY HEALTH DEPARTMENT

STATESVILLE 704-878-5305 MOORESVILLE 704-664-5281

IMPROVEMENT PERMIT / AUTHORIZATION TO CONSTRUCT / OPERATION PERMIT / EXISTING SYSTEM INSPECTION

PERMIT# 04 - 2 - 040 PIN# 4741 40 6667 DATE 4/24/01

OWNER OR CONTRACTOR KELLY E. CARRIGAN PHONE: Business _____ Home (704) 528- 5316

ADDRESS 132 CARRIGAN RD., TROUTMAN NC 28166

LOCATION 21 S (R) CARRIGAN RD. (R) TAHOE LN. TO END

SUBDIVISION _____ BLOCK / SECTION _____ LOT _____ LOT AREA _____ SITE CLASS _____ DESIGN FLOW _____ L.T.A.R. _____

Septic Tank: EXISTING Gallons: STB _____ Date _____
Pump Tank: _____ Gallons: PT _____ Date _____
Pump Make: _____ Model _____ Serial No. _____
Nitrification Field: No Fields ____ Square Feet _____ Linear Feet _____
No Lines _____ Trench Width _____ Max Trench Bottom Depth _____ Gravel Depth _____

☐ New System ☐ Repair System Type: I, II, III, IV, V, VI
System Description: _____
Repair System Description: _____
Maintenance Agreement Required: ☐ Yes ☐ No
☐ Slab ☑ Crawl Space ☐ Basement w/plumbing ☐ Basement wo/plumbing


☐ House/Mod. Home No. Bedrooms 3
☑ Mobile Home No. Bathrooms 2
☐ Business No. Employees ____
☐ Other _____

Water Supply:
☑ Individual
☐ Public
☐ Community


Comments/Conditions:

Comments/Conditions: ① PUMP SEPTIC TANK EVERY 3-5 YRS. ② NO CUTTING OR FILLING OVER DRAINFIELD AREAS ③ KEEP ALL DRAINS AWAY FROM DRAINFIELD AREAS

INITIAL SITE SKETCH

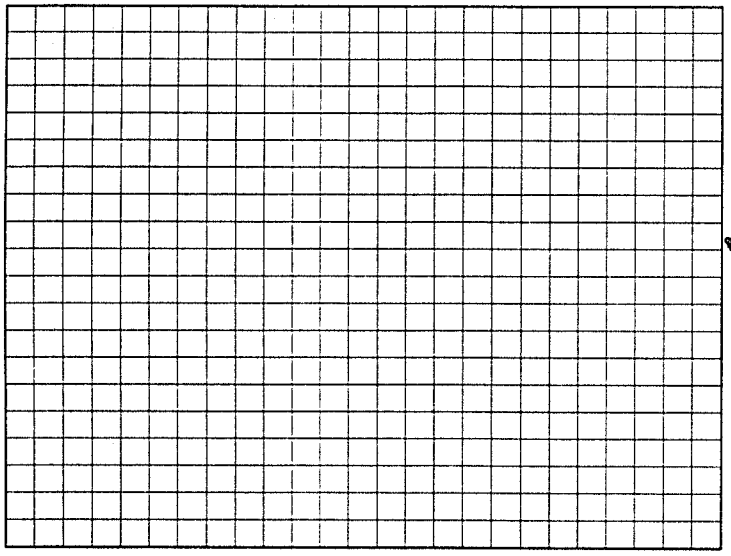

AS BUILT SKETCH

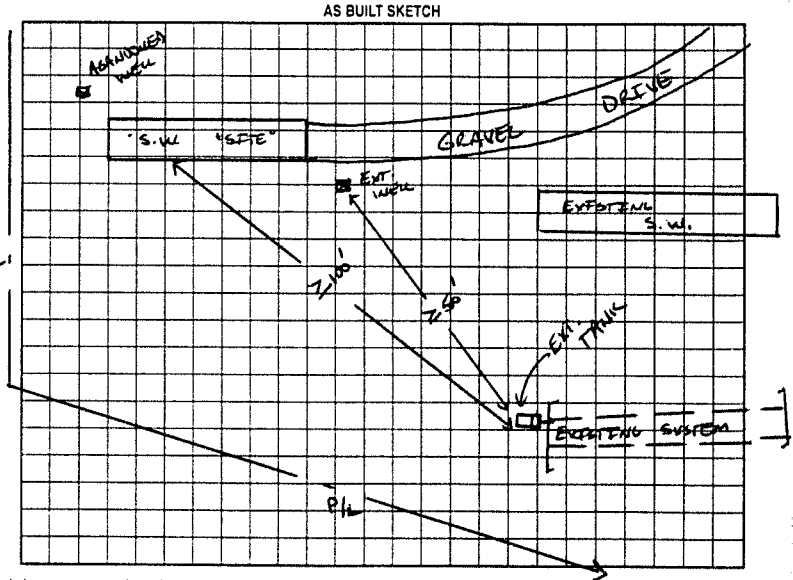

Permit can be suspended or revoked if any false information is supplied toward securing the permit/any unauthorized changes are made to the site/any unauthorized changes are made in the installation of the system. Improvement Permit with plat valid without expiration. Improvement Permit with site plan valid for sixty months. Authorization to Construct is valid for a period equal to that of Improvement Permit – not to exceed sixty months.

Signed: Kelly E. Carrigan date 4-25-01 Installed by: _____

Improvement Permit by: _____ date _____ Operation Permit by: _____ date _____

Authorization to Construct by: _____ date _____ Existing System Inspection by: Duane Shinn date 4/24/01

HEALTH DEPT COPY WHITE OWNER COPY (FINAL) YELLOW OWNER COPY (INITIAL) PINK