IREDELL COUNTY HEALTH DEPARTMENT

STATESVILLE 704-878-5305 MOORESVILLE 704-664-5281

IMPROVEMENT PERMIT / CERTIFICATE OF COMPLETION / OPERATION PERMIT / EXISTING SYSTEM INSPECTION

PROPERTY DESCRIPTION NO. Troutman 060928 DATE 4-10-97 TAX MAP NO. 4N-1-E-10B

OWNER OR CONTRACTOR Heritage Bldg Co. PHONE: Business 528 6644 Home 872-3421

ADDRESS 120 Hickory Pt. Ct. Watershed: ☐ Yes ☒ No

LOCATION 21 South to TR Byers Rd 1/4 mi left

SUBDIVISION Jacobs Woods BLOCK / SECTION ____ LOT 1 LOT AREA 1.66 acres SITE CLASS PS DESIGN FLOW 360 L.T.A.R. .33

Septic Tank: 1000 Gallons; STB PT Date 2-2-95

Pump Tank: ____ Gallons; PT ____ Date ____

Pump Make: ____ Model ____ Serial No. ____

Nitrification Field: No Fields 1 Square Feet 1080 Linear Feet 360

No Lines 3 Trench Width 36" Max Trench Bottom Depth 36" Gravel Depth 12"

☒ New System ☐ Repair System Type: I, II, III, IV, V, VI

System Description: Conv. Gravity

Repair System Description: " "

Maintenance Agreement Required: ☐ Yes ☒ No

☒ House/Mod. Home No. Bedrooms 3

☐ Mobile Home No. Bathrooms 2

☐ Business No. Employees ____

☐ Other ____


☐ Slab ☒ Crawl Space ☐ Basement w/plumbing ☐ Basement wo/plumbing

Water Supply: ☒ Individual ☐ Community ☐ Public


Comments:

Comments:

INITIAL SITE SKETCH

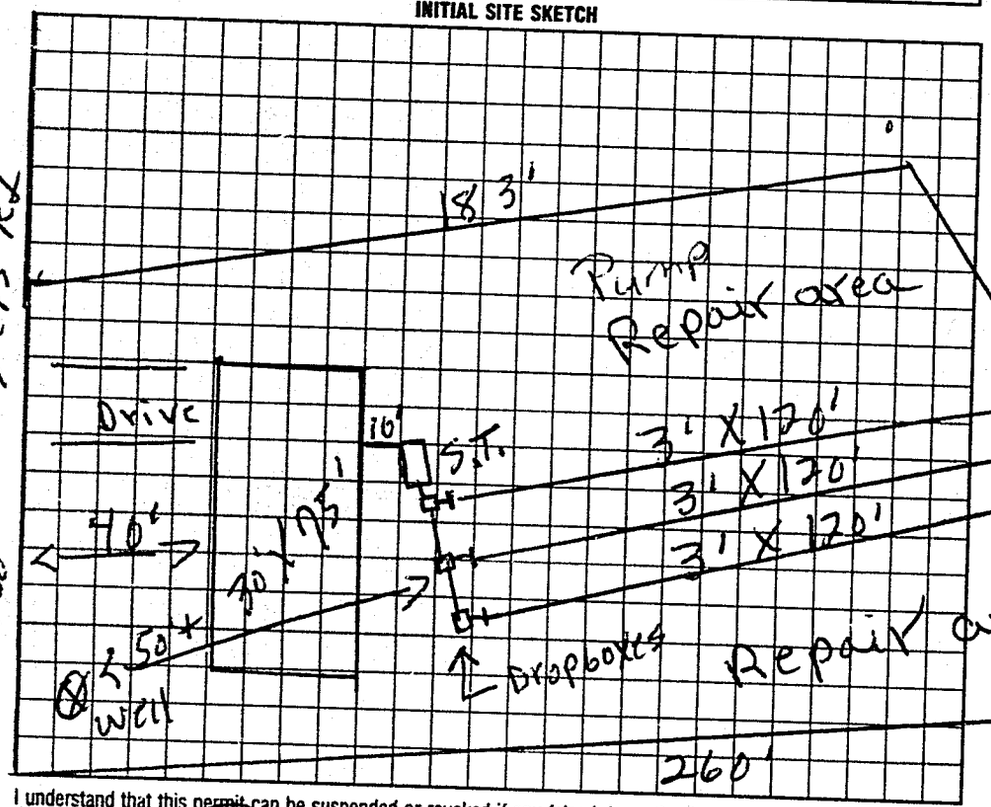

AS BUILT SKETCH

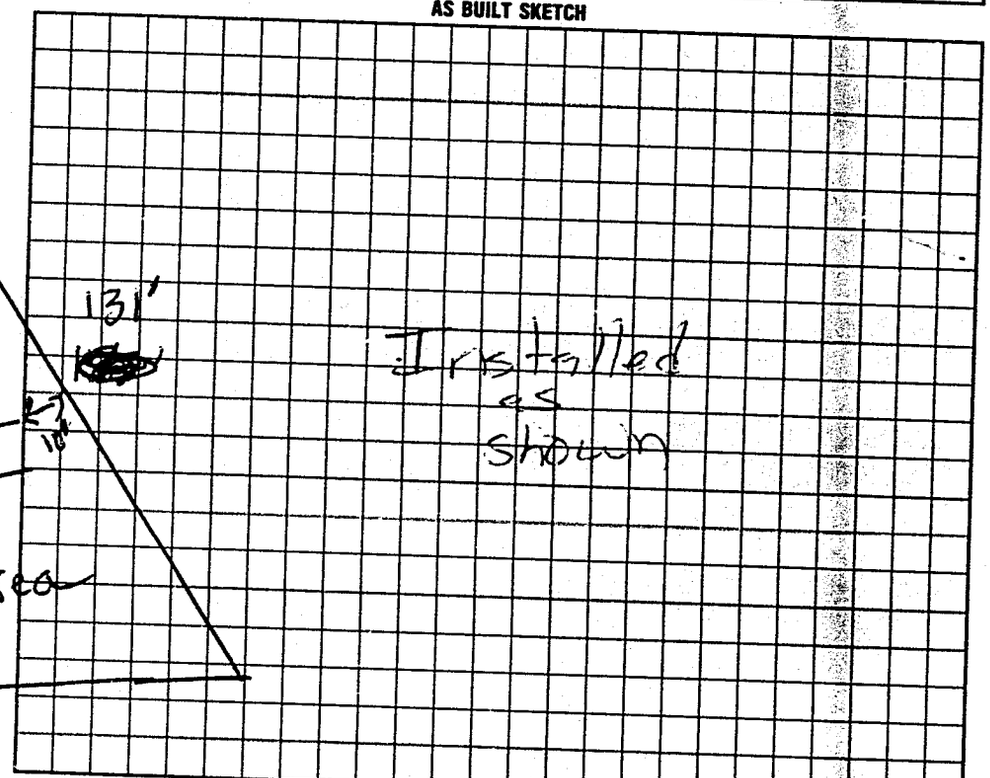

I understand that this permit can be suspended or revoked if any false information is supplied toward securing the permit/any unauthorized changes are made to the site/any unauthorized changes are made in the installation of the system. Improvement Permit is valid for 60 months from date of issuance.

Signed: X Paul Lyon

Improvement Permit by: P.C. Moore date 4-10-97

Existing System Inspection by: Authorization P.C. Moore date 4-10-97

to come

Installed by: Tommy Frye

Certificate of Completion by: ____ date ____

Operation Permit by: Matt Curtis date 4-8-98

HEALTH DEPT COPY: WHITE INSPECTION COPY (FINAL): GREEN OWNER COPY (FINAL): YELLOW INSPECTION COPY (INITIAL): PINK OWNER COPY (INITIAL): GOLD

authorization to count. Expires 60 months from issue date