IREDELL COUNTY HEALTH DEPARTMENT

STATESVILLE 704-878-5305 MOORESVILLE 704-664-5281

IMPROVEMENT PERMIT / AUTHORIZATION TO CONSTRUCT / OPERATION PERMIT / EXISTING SYSTEM INSPECTION

PERMIT# TROUTMAN PIN# 4741-41-4245 DATE 1-13-04

OWNER OR CONTRACTOR KENNETH BEALER HOMES PHONE: Business 704-662-6400 Home 704-622-0113

ADDRESS P.O. BOX 3398 MOORESVILLE, NC 28117

LOCATION US 21 SOUTH TR BYERS' ROAD, LOT ON LEFT AT BOX #149, BACK OFF ROAD 500 FEET

SUBDIVISION JACOBS WOOD BLOCK / SECTION 1 LOT 4 LOT AREA 2.17 ACRES SITE CLASS. PS DESIGN FLOW 360 L.T.A.R. 0.35 gpd/ft²

Septic Tank: 1000 Gallons; STB 1012 Date 7-26-02

Pump Tank: _____ Gallons; PT _____ Date _____

Pump Make: _____ Model _____ Serial No. _____

Nitrification Field: No Fields 1 Square Feet 1035 Linear Feet 345

No Lines FOUR Trench Width 36" Max Trench Bottom Depth 36" Gravel Depth 12"

☑ New System ☐ Repair System Type: I, II, III, IV, V, VI

System Description: CONVENTIONAL GRAVITY

Repair System Description: CONVENTIONAL, PUMP

Maintenance Agreement Required: ☐ Yes ☑ No

☑ House/Mod. Home No. Bedrooms 3

☐ Mobile Home No. Bathrooms 2.5

☐ Business No. Employees ____

☐ Other _____


☐ Slab ☑ Crawl Space ☐ Basement w/plumbing ☐ Basement wo/plumbing

Water Supply: ☐ Individual ☑ Public ☐ Community

Comments:/Conditions: INSTALL SYSTEM ON CONTOUR AS SHOWN

Comments:/Conditions: TUFFTITE FILTER & RISERS
V'D LAST 3 LINES ON 5-12-04 & TANK.
GOT RAINED OUT
V'D 1ST LINE 5-13-04 EVERYTHING OK

INITIAL SITE SKETCH

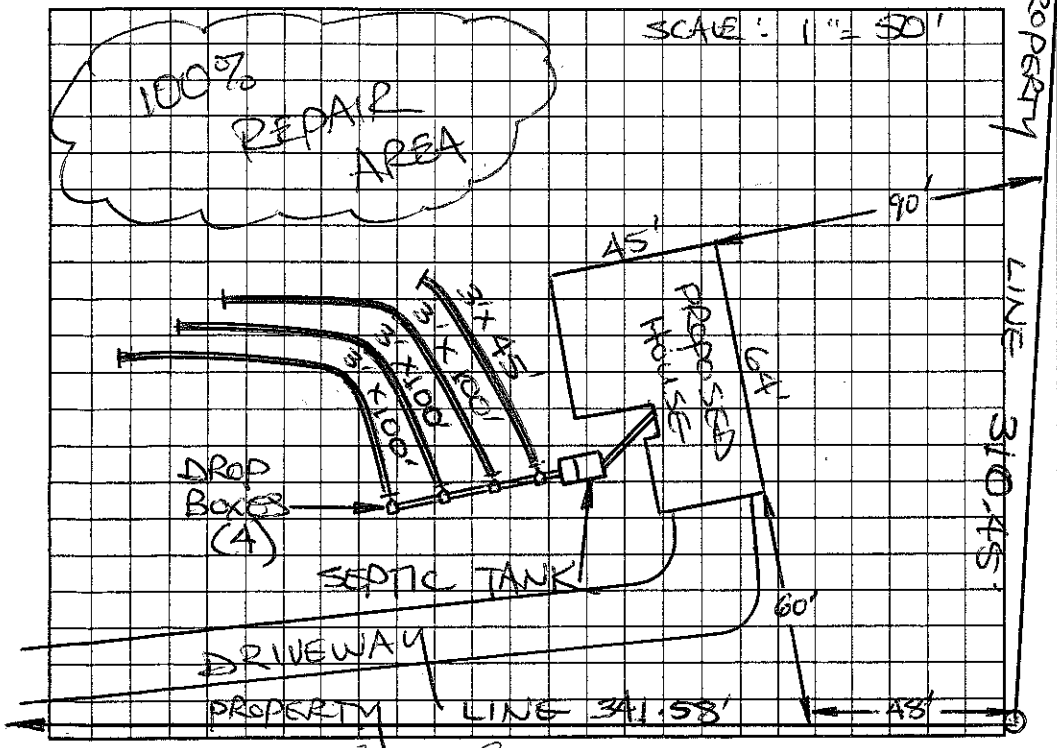

AS BUILT SKETCH

Permit can be suspended or revoked if any false information is supplied toward securing the permit/any unauthorized changes are made to the site/any unauthorized changes are made in the installation of the system. Improvement Permit with plat valid without expiration. Improvement Permit with site plan valid for sixty months. Authorization to Construct is valid for a period equal to that of Improvement Permit – not to exceed sixty months.

Signed: _____ date 1/15/04 Installed by: STEVE JORDAN

Improvement Permit by: STEVE HEDRICK date 1-13-04 Operation Permit by: _____ date 5-13-04

Authorization to Construct by: STEVE HEDRICK date 1-13-04 Existing System Inspection by: _____ date _____

HEALTH DEPT. COPY: WHITE OWNER COPY (FINAL): YELLOW OWNER COPY (INITIAL): PINK