59313 59313

IREDELL COUNTY HEALTH DEPARTMENT

STATESVILLE 704-878-5305 MOORESVILLE 704-664-5281

IMPROVEMENT PERMIT / CERTIFICATE OF COMPLETION / OPERATION PERMIT / EXISTING SYSTEM INSPECTION

PROPERTY DESCRIPTION NO TROUTMAN DATE 2-9-96 TAX MAP NO 4L-A-21 Watershed: Yes ✓ No

OWNER OR CONTRACTOR DAN & KAREN BAKER PHONE: Business Home 871-1544

ADDRESS 554 PERRY ROAD TROUTMAN NC 28166

LOCATION US 21 S, TL PERRY ROAD, LOT ON RIGHT ~ 1.5 MILE AT BOX # 554, BACK OFF ROAD

SUBDIVISION BLOCK / SECTION LOT LOT AREA ~2.9 Ac SITE CLASS PS DESIGN FLOW 360 L.T.A.R. 0.30 GPD/FT²

Septic Tank: 1000 Gallons: STB 794 Date 5-5-96
Pump Tank: Gallons: PT Date
Pump Make: Model: Serial No
Nitrification Field: No Fields 1 Square Feet 1200 Linear Feet 400
No Lines 4 Trench Width 36" Max Trench Bottom Depth 18-36" Gravel Depth 12"

✓ New System Repair System Type: I II III IV V
System Description: CONVENTIONAL GRAVITY
Repair System Description: CONVENTIONAL GRAVITY
Maintenance Agreement Required Yes ✓ No


✓ House/Mod. Home No. Bedrooms 3
Mobile Home No. Bathrooms 2½
Business No. Employees
Other
Slab Crawl Space Basement w/plumbing ✓ Basement wo/plumbing

Water Supply: ✓ Individual ☐ Community ☐ Public WELL

Comments: ① USE THREE FLOW DIVIDER TEES FOR EQUAL DIST. INTO EACH OF FOUR 100' LINES ② KEEP SYSTEM MINIMUM 100' FROM WELL, 15' FROM BASEMENT; 10' FROM PROPERTY LINE

Comments:

INITIAL SITE SKETCH

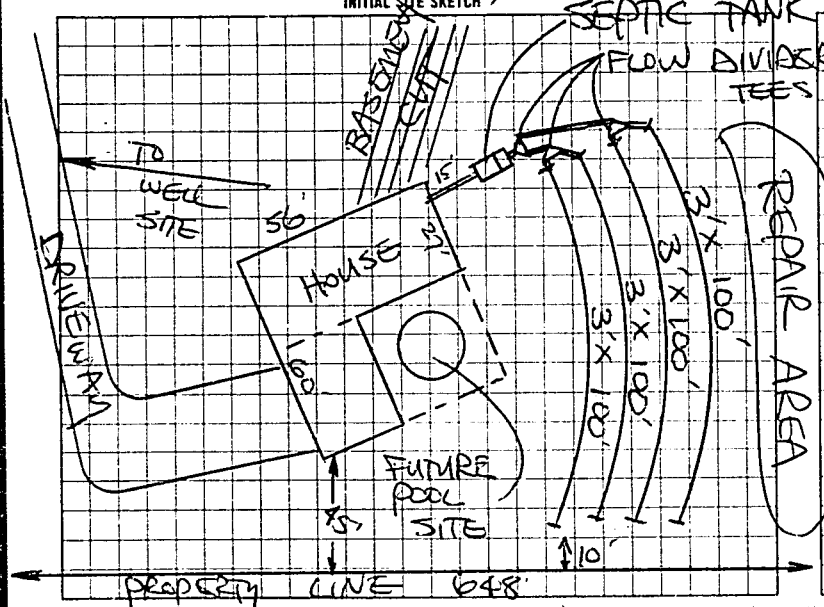

AS BUILT SKETCH

SYSTEM INSTALLED ACCORDING TO INITIAL SITE SKETCH

I understand that this permit can be suspended or revoked if any false information is supplied toward securing the permit/any unauthorized changes are made to the site/any unauthorized changes are made in the installation of the system

AUTHORIZATION TO CONSTRUCT IS VALID FIVE (5) YEARS FROM DATE OF ISSUANCE. IMPROVEMENT PERMIT HAS NO EXPIRATION DATE

Signed ✓ Dan Baker

Improvement Permit by STEVE HEDRICK date 2-9-96

Authorization to Construct by STEVE HEDRICK date 2-9-96

Installed by DAN BAKER (OWNER) date

Certificate of Completion by date

Operation Permit by STEVE HEDRICK date 6-17-96

Existing System Inspection by

REGISTERED COPY WHITE INSPECTION COPY (DRIVE) GREEN OWNER COPY (DRIVE) YELLOW REGISTERED COPY (DRIVE) PINK OWNER COPY (DRIVE) GOLD

0024229