IREDELL COUNTY HEALTH DEPARTMENT

CI 700.00 Paid

STATESVILLE 704-878-5305 MOORESVILLE 704-664-5281

IMPROVEMENT PERMIT / AUTHORIZATION TO CONSTRUCT / OPERATION PERMIT / EXISTING SYSTEM INSPECTION

PERMIT# ~~#27657~~/32045 PIN# 4742 40 8402 14997?4 DATE 10/4/05

OWNER OR CONTRACTOR MATTHEW CASH PHONE: Business 704 682 2530 Home

ADDRESS 178 LEONA LN TROUTMAN, NC 28166

LOCATION 77S @ AMITY HILL @ MURDOCK @ LEONA LN @ LOT 0.5 MILE & 0.3 MILE off ROAD

SUBDIVISION NA BLOCK / SECTION LOT LOT AREA 16 ACRES SITE CLASS. PS DESIGN FLOW 360 gpd L.T.A.R. .35

Septic Tank: 1000 Gallons; STB 794 Date 1-30-06
Pump Tank: 1000 Gallons; PT 283 Date 4-4-06
Pump Make: GOULDS Model WE0311M Serial No. K05177563
Nitrification Field: No Fields 1 Square Feet EQ 1028 Linear Feet 258
No Lines 3 Trench Width 36" Max Trench Bottom Depth 24" Gravel Depth NA

☒ New System ☐ Repair System Type: I, II, (III), IV, V, VI
System Description: PUMP 25% REDUCTION
Repair System Description: SAME
Maintenance Agreement Required: ☐ Yes ☒ No

☒ House/Mod. Home No. Bedrooms 3
☐ Mobile Home No. Bathrooms
☐ Business No. Employees
☐ Other


☐ Slab ☒ Crawl Space ☐ Basement w/plumbing ☐ Basement wo/plumbing

Water Supply: ☒ Individual ☐ Public ☐ Community

Comments:/Conditions: INSTALL ON CONTOUR. INSTALL SUB-SURFACE INTERCEPTOR DRAIN AS SHOWN 36" DEEP.

Comments:/Conditions: SEPTIC TANK WITH MARKER INSTALLED USING RED "Polylok" FILTER

INITIAL SITE SKETCH

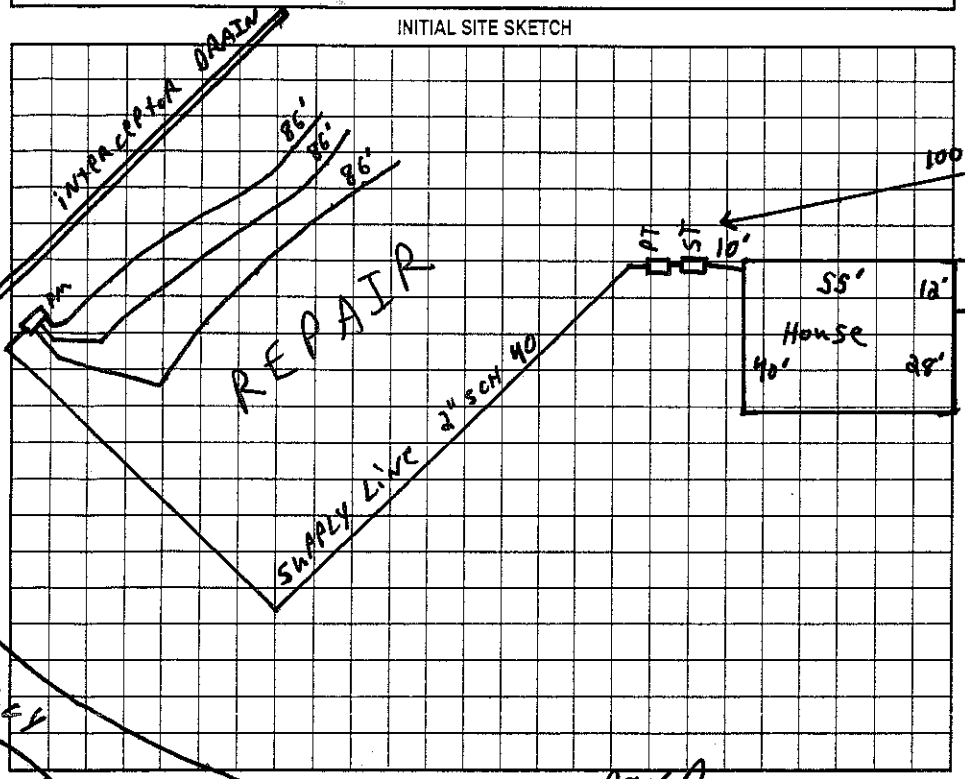

AS BUILT SKETCH

SYSTEM INSTALLED ACCORDING TO INITIAL SITE SKETCH

Permit can be suspended or revoked if any false information is supplied toward securing the permit/any unauthorized changes are made to the site/any unauthorized changes are made in the installation of the system. Improvement Permit with plat valid without expiration. Improvement Permit with site plan valid for sixty months. Authorization to Construct is valid for a period equal to that of Improvement Permit – not to exceed sixty months.

Signed: Matthew Cash date 10/11/05 Installed by: TUCKER'S HAULING & GRADING

Improvement Permit by: [signature] date 10/4/05 Operation Permit by: [signature] date 6.6.06

Authorization to Construct by: [signature] date 10/11/05 Existing System Inspection by: date

HEALTH DEPT. COPY: WHITE OWNER COPY (FINAL): YELLOW OWNER COPY (INITIAL): PINK