81733

IREDELL COUNTY HEALTH DEPARTMENT

STATESVILLE 704-878-5305 MOORESVILLE 704-664-5281

IMPROVEMENT PERMIT / AUTHORIZATION TO CONSTRUCT / OPERATION PERMIT / EXISTING SYSTEM INSPECTION

PERMIT# 01-Z-699 PIN# 4741-51-2201 DATE 6-21-99

OWNER OR CONTRACTOR KELLY E. CARRIGAN PHONE: Business Home 528-5316

ADDRESS 132 CARRIGAN ROAD TROUTMAN NC 28166

LOCATION US 21 SOUTH, 2ND MH ON RIGHT BEFORE CARRIGAN ROAD

SUBDIVISION B&S MHP BLOCK / SECTION LOT LOT AREA 0.445 SITE CLASS. PS DESIGN FLOW 240 L.T.A.R. 0.50 GPD/FT²

Septic Tank: 1000 Gallons; STB 774 Date 2-3-99

Pump Tank: Gallons; PT Date

Pump Make: Model Serial No.

Nitrification Field: No Fields 1 Square Feet 480 Linear Feet 160

No Lines THREE Trench Width 36" Max Trench Bottom Depth 36" Gravel Depth 12"

☒ New System ☐ Repair System Type: I (II) III, IV, V, VI

System Description: CONVENTIONAL, GRAVITY

Repair System Description: 25% REDUCTION

Maintenance Agreement Required: ☐ Yes ☒ No

☐ House/Mod. Home ☒ Mobile Home ☐ Business ☐ Other

No. Bedrooms 2 No. Bathrooms 2 No. Employees


☐ Slab ☒ Crawl Space ☐ Basement w/plumbing ☐ Basement wo/plumbing

Water Supply: ☒ Individual ☐ Public ☐ Community WELL


Comments/Conditions: SYSTEM SIZED FOR TWO BEDROOM ONLY.

Comments /Conditions:

INITIAL SITE SKETCH

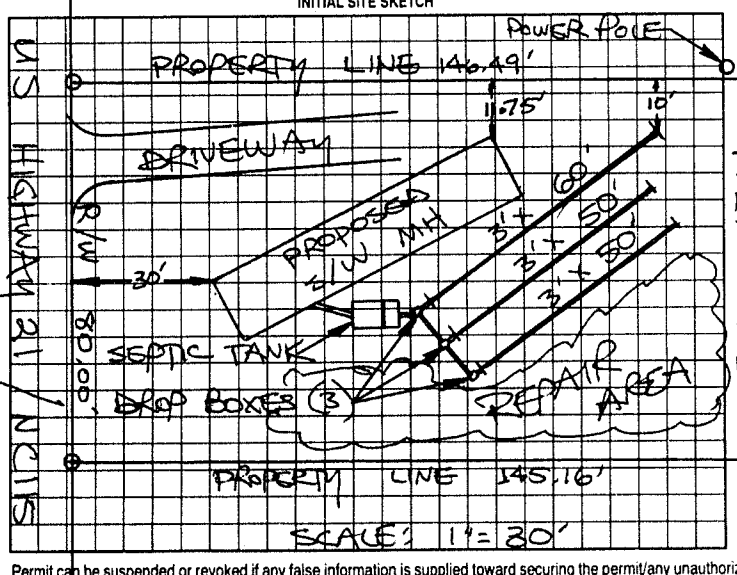

AS BUILT SKETCH

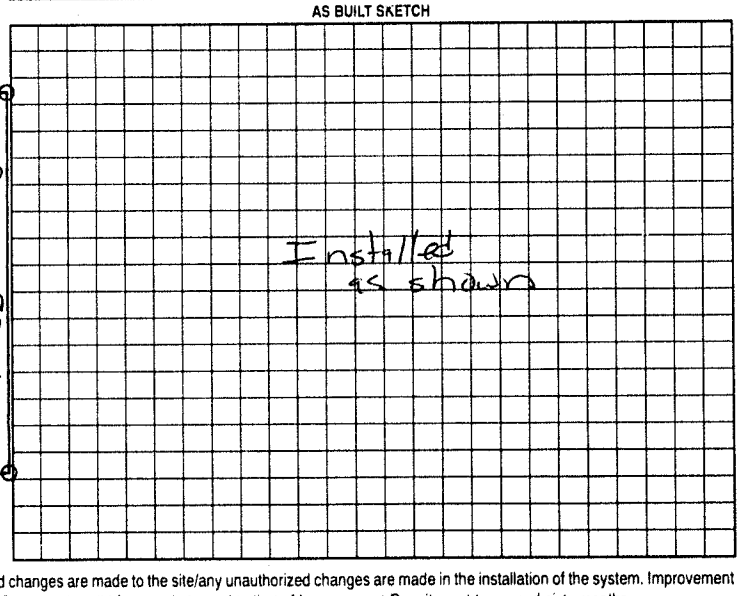

Permit can be suspended or revoked if any false information is supplied toward securing the permit/any unauthorized changes are made to the site/any unauthorized changes are made in the installation of the system. Improvement Permit with plat valid without expiration. Improvement Permit with site plan valid for sixty months. Authorization to Construct is valid for a period equal to that of Improvement Permit – not to exceed sixty months.

Signed: Kelly E. Carrigan date 6-21-99

Improvement Permit by: STEVE HEDRICK date 6-21-99

Authorization to Construct by: STEVE HEDRICK date 6-21-99

Installed by: Wes Lytton

Operation Permit by: Mark C Outlaw RS date 6-24-99

Existing System Inspection by: date

HEALTH DEPT COPY WHITE OWNER COPY (FINAL) YELLOW OWNER COPY (INITIAL) PINK