IREDELL COUNTY HEALTH DEPARTMENT - *ENVIRONMENTAL HEALTH* ☒ STATESVILLE OFFICE 704-878-5305 ☐ MOORESVILLE OFFICE 704-664-5281

IMPROVEMENT PERMIT / AUTHORIZATION TO CONSTRUCT / OPERATION PERMIT / EXISTING SYSTEM INSPECTION

PERMIT # 170266 PIN # 4741-57-5541 DATE 1-30-12

OWNER Tony R Boyd APPLICANT: PHONE: Home/Cell # 704 902 1548 Business #

SITE ADDRESS 550 Hoover Rd OWNER / APPLICANT ADDRESS

SITE DIRECTIONS 775 x 45, (L) on Murdock Rd, (L) Hoover site will be on right just before creek (new gravel rd.)

SUBDIVISION n/a BLOCK / SECTION LOT # n/a LOT AREA n/a 23.153 DESIGN FLOW 360 L.T.A.R. .25

Septic Tank 1000 Gallons: STB 1012 Date 2-6-12 ☒ New System ☐ Repair ☐ Expansion System Type I II (III) IV V VI ☒ Residence No. Bedrooms 3 Water Supply ☒ Private

Pump Tank Gallons: P T Date ☐ Business No. Persons ☐ Public

Pump Make Model Serial # System Description: 25% Reduction Gravity ☐ Other No. Employees ☐ Community


No. Nitrification Fields: 1 No. Lines 4 Linear Feet 360 Repair System Description: 25% Reduction Gravity ☐ Slab ☒ Crawl Space

Trench Width 36" Max. Trench Bottom Depth 36" Gravel Depth n/a Maintenance Agreement Required ☐ YES ☒ NO ☐ Basement w/plumbing ☐ Basement w/o plumbing


☒ GRAVITY ☐ PRESSURE

Comments / Conditions

INITIAL SITE SKETCH

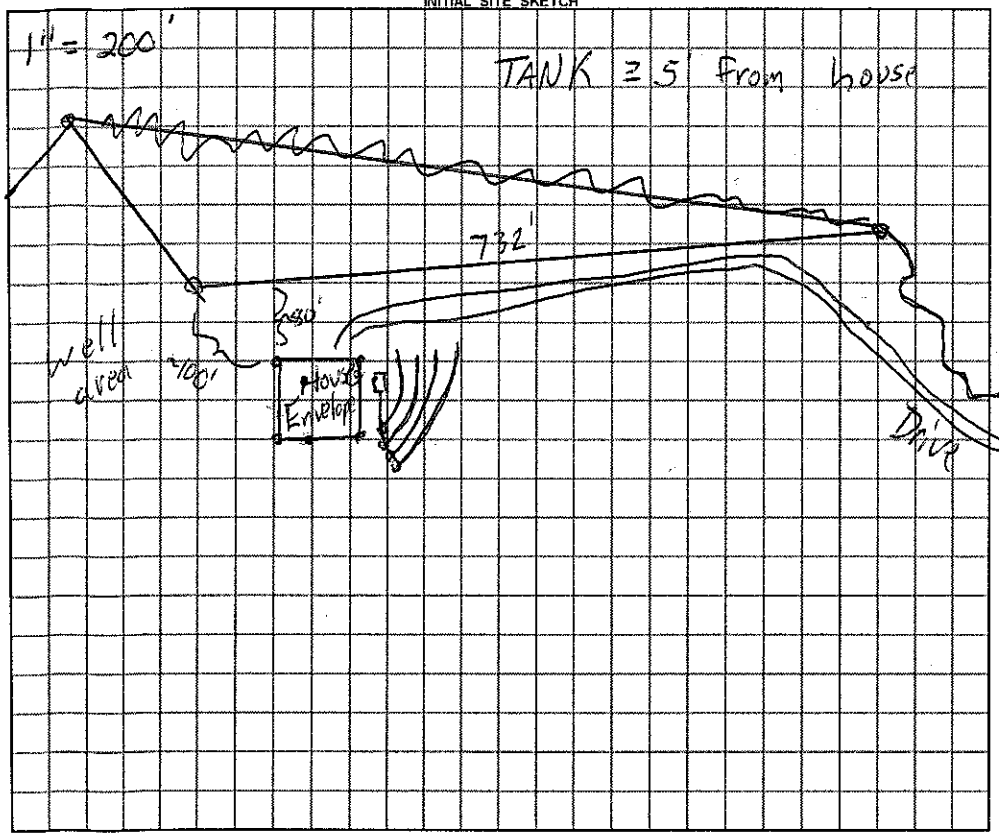

AS BUILT SKETCH

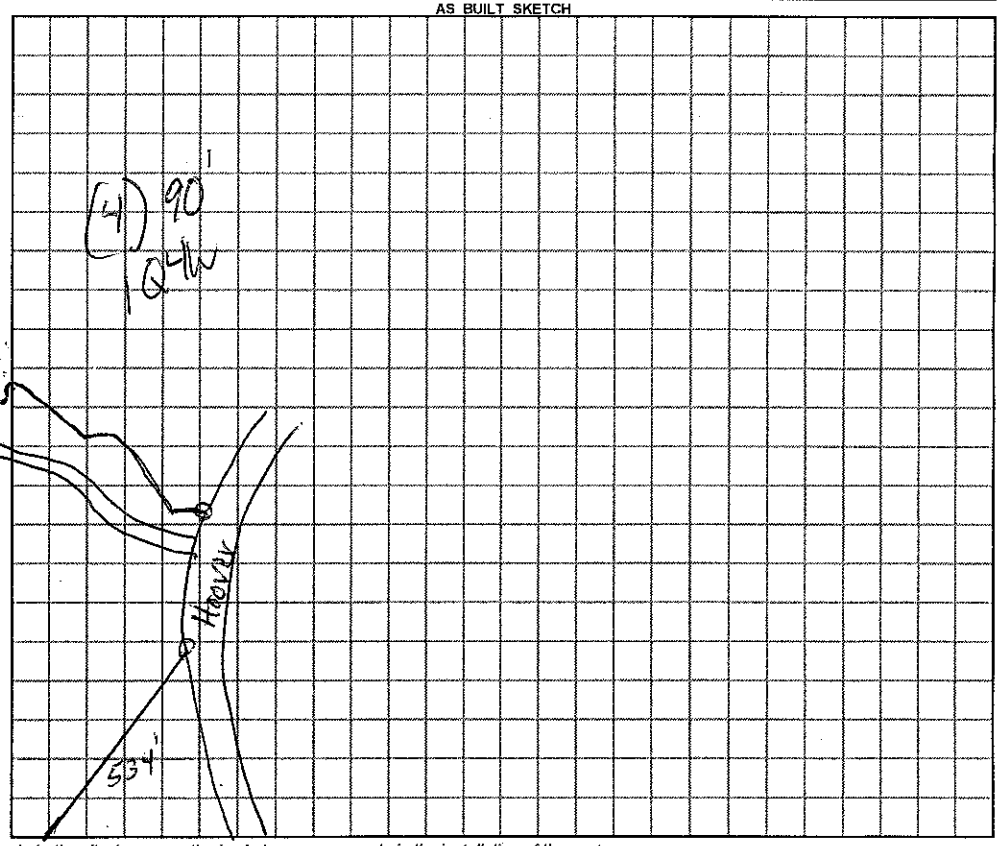

Permit can be suspended or revoked if any false information is supplied toward securing the permit / any unauthorized changes are made to the site / any unauthorized changes are made in the installation of the system.

☐ *IMPROVEMENT PERMIT with plat valid without expiration.* ☒ *IMPROVEMENT PERMIT with plat valid without expiration. site plan valid 60 mo.* ☒ *AUTHORIZATION TO CONSTRUCT* valid for period equal to IMPROVEMENT PERMIT--not to exceed 60 mo.

Owner / Applicant Signature: Tony R Boyd Date 1/30/12 Installed by: David Young

IMPROVEMENT PERMIT by: James REHS Date 1-30-12 OPERATION PERMIT by: James REHS Date 6-15-12

AUTHORIZATION TO CONSTRUCT by: James REHS Date 1-30-12 Existing System Inspected by: REHS Date

YOU SHOULD CONTACT A LOCATOR SERVICE PRIOR TO ANY EXCAVATION

White Copy – Environmental Health YELLOW COPY (Final) Owner / Applicant PINK COPY (Initial) Owner / Applicant