12/3/15 Called In

IREDELL COUNTY HEALTH DEPARTMENT

STATESVILLE 704-878-5305 MOORESVILLE 704-664-5281

IMPROVEMENT PERMIT / AUTHORIZATION TO CONSTRUCT / OPERATION PERMIT / EXISTING SYSTEM INSPECTION

PERMIT# 05-P-12-03 PIN# 4741-63-2479 DATE 5-19-04

OWNER OR CONTRACTOR JERRY DAVENPORT PHONE: Business 704-577-0536 Home 704-528-6032

ADDRESS PO BOX 1234 MOORESVILLE, NC 28115

LOCATION 21 SOUTH (C) OSTWALT SMITH (C) PERRY, 2ND LOT ON LEFT PAST LEVO DR

SUBDIVISION _____ BLOCK / SECTION _____ LOT 8 LOT AREA 16.5 AC SITE CLASS. B DESIGN FLOW 480 L.T.A.R. .3

Septic Tank: 1000 Gallons; STB TB 1012 Date 4-5-05
Pump Tank: _____ Gallons; PT _____ Date _____
Pump Make: _____ Model _____ Serial No. _____
Nitrification Field: No Fields 1 Square Feet 1660 Linear Feet 533'
No Lines 4x133' Trench Width 36" Max Trench Bottom Depth 36" Gravel Depth 12"

☒ New System ☐ Repair System Type: I, (II), III, IV, V, VI
System Description: CONV GRAV
Repair System Description: SAME
Maintenance Agreement Required: ☐ Yes ☒ No


☒ House/Mod. Home No. Bedrooms 4
☐ Mobile Home No. Bathrooms 2 1/2
☐ Business No. Employees ____
☐ Other _____
☐ Slab ☒ Crawl Space ☐ Basement w/plumbing ☐ Basement wo/plumbing

Water Supply: ☒ Individual ☐ Public ☐ Community


Comments:/Conditions: (1) KEEP WELL 100' FROM ANY PART OF SYSTEM & REPAIR (2) INSTALL LINES ON CONTOURS (3) MAINTAIN SETBACKS (4) SYSTEM DESIGNED WITH HOUSE STAKED OUT ON SITE

Comments:/Conditions: BUILDING A 3 BEDROOM HOUSE, INSTALLING SYSTEM FOR A 4 BEDROOM, PERMIT REPLACES PREVIOUSLY ISSUED PERMIT DATED 2-10-04

INITIAL SITE SKETCH "NOT TO SCALE"

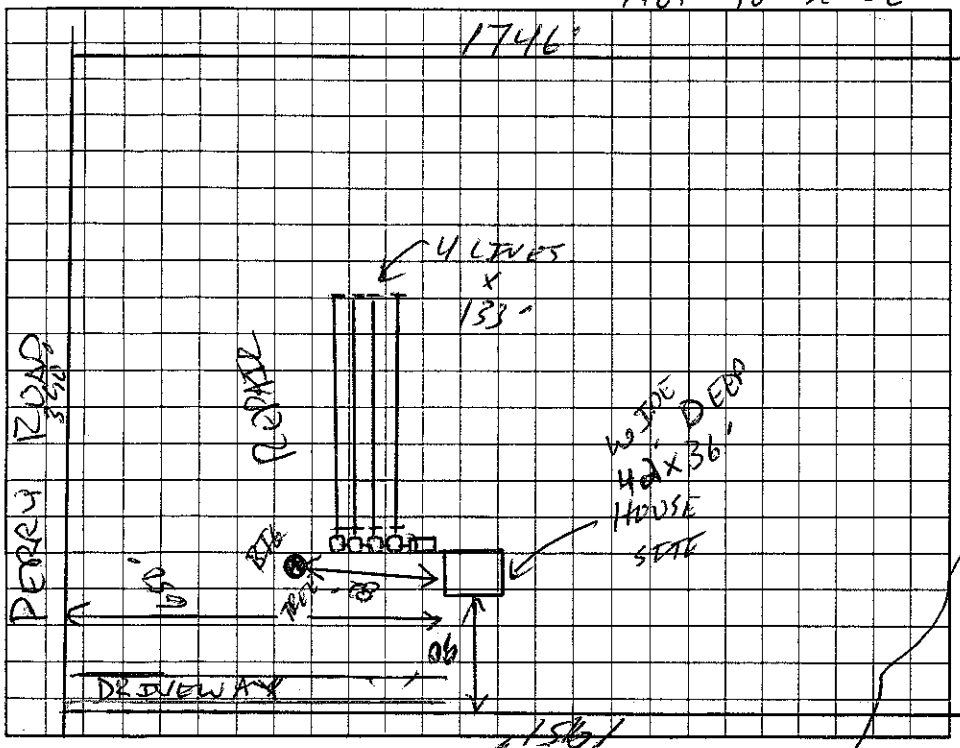

AS BUILT SKETCH

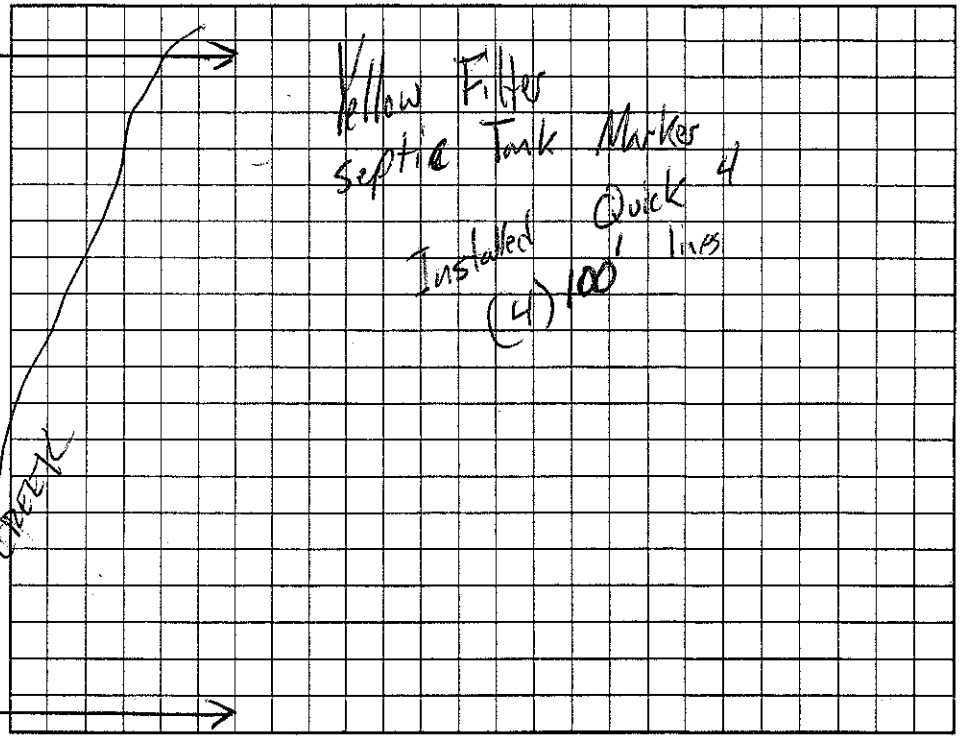

Permit can be suspended or revoked if any false information is supplied toward securing the permit/any unauthorized changes are made to the site/any unauthorized changes are made in the installation of the system. Improvement Permit with plat valid without expiration. Improvement Permit with site plan valid for sixty months. Authorization to Construct is valid for a period equal to that of Improvement Permit – not to exceed sixty months.

Signed: _____ date 5-21-04 Installed by: A-1 Backhoe

Improvement Permit by: _____ date 5-19-04 Operation Permit by: _____ date 10-27-05

Authorization to Construct by: _____ date 5-14-04 Existing System Inspection by: _____ date _____

HEALTH DEPT. COPY: WHITE OWNER COPY (FINAL): YELLOW OWNER COPY (INITIAL): PINK