IREDELL COUNTY HEALTH DEPARTMENT

STATESVILLE 704-878-5305 MOORESVILLE 704-664-5281

IMPROVEMENT PERMIT / CERTIFICATE OF COMPLETION / OPERATION PERMIT / EXISTING SYSTEM INSPECTION

PROPERTY DESCRIPTION NO. 19197 068458 DATE 6-17-97 TAX MAP NO. 46-1-A-18,19 Watershed: ☐ Yes ☑ No

OWNER OR CONTRACTOR John + Laura Barry PHONE: Business Home 662 0649

ADDRESS 370 Water St Mooresville, N.C.

LOCATION 215 To Perry Rd at Troutman, TR Levelon 1/8 mi Rt,

SUBDIVISION Perry Heights BLOCK / SECTION LOT 18+19 LOT AREA 1.5 acre+ SITE CLASS. RS DESIGN FLOW 360 L.T.A.R. .33

Septic Tank: 1000 Gallons; STB 1212 Date 12-1-97

Pump Tank: Gallons; PT Date

Pump Make: Model Serial No.

Nitrification Field: No Fields 1 Square Feet 1080 Linear Feet 360

No Lines 4 Trench Width 36" Max Trench Bottom Depth 36" Gravel Depth 12"

☑ New System ☐ Repair System Type: I, II, III, IV, V, VI

System Description: Conv. Gravity

Repair System Description: Pump To Chambers

Maintenance Agreement Required: ☐ Yes ☐ No

☐ House/Mod. Home No. Bedrooms 3

☐ Mobile Home No. Bathrooms 3

☐ Business No. Employees

☑ Other


☐ Slab ☐ Crawl Space ☑ Basement w/plumbing ☐ Basement wo/plumbing

Water Supply: ☑ Individual ☐ Community ☐ Public

Comments: Replaces permit issued 7-25-94


313'

INITIAL SITE SKETCH

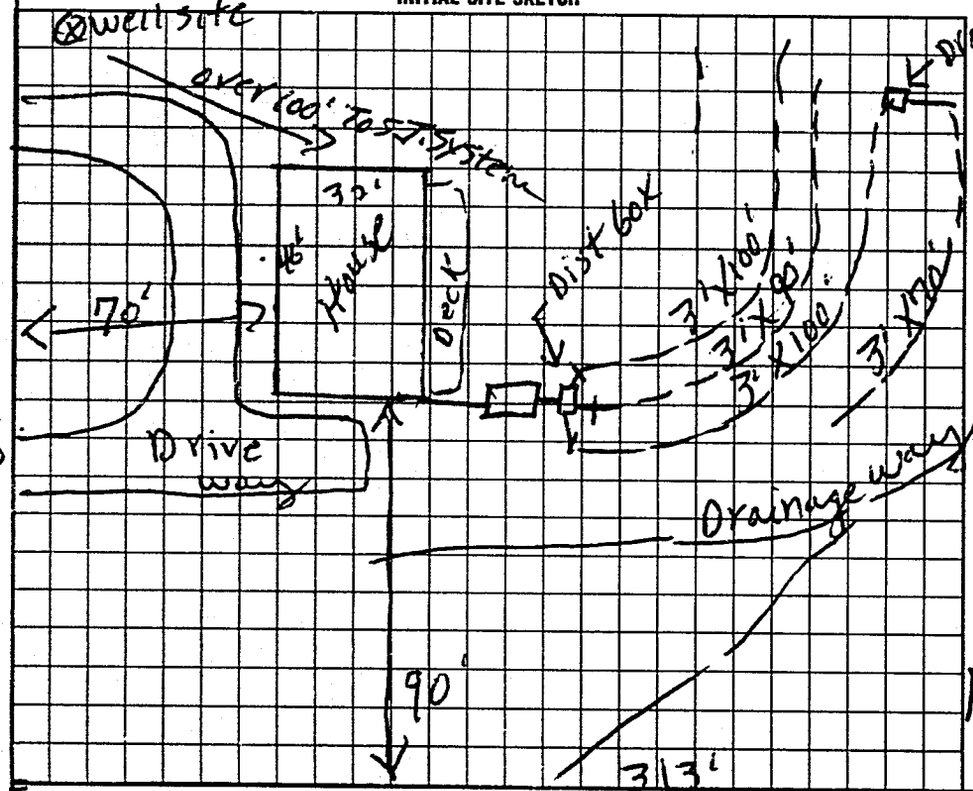

Comments: XNote: Pump gutter drains away from system — Emb 8" lines deep — Area to be cut + landscaped

AS BUILT SKETCH

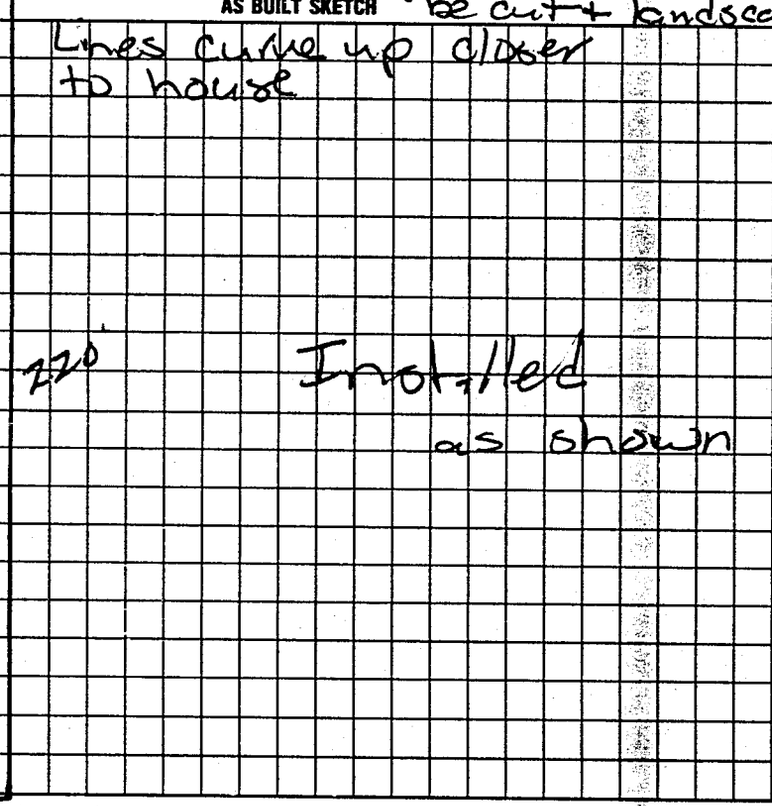

I understand that this permit can be suspended or revoked if any false information is supplied toward securing the permit/any unauthorized changes are made to the site/any unauthorized changes are made in the installation of the system. Improvement Permit is valid for 60 months from date of issuance.

Signed: X

Improvement Permit by D.C. Moore date 6-17-97

Existing system inspection by D.C. Moore date 6-17-97

Installed by: Forest Shuford

Certificate of Completion by: date

Operation Permit by Mark Craft RS date 3-12-98

Authorization to Cont.

Authorization to Cont. Expires 60 mos from issue

HEALTH DEPT. COPY: WHITE INSPECTION COPY (FINAL): GREEN OWNER COPY (FINAL): YELLOW INSPECTION COPY (INITIAL): PINK OWNER COPY (INITIAL): GOLD