# IREDELL COUNTY HEALTH DEPARTMENT

STATESVILLE 704-878-5305 MOORESVILLE 704-664-5281

## IMPROVEMENT PERMIT / AUTHORIZATION TO CONSTRUCT / OPERATION PERMIT / EXISTING SYSTEM INSPECTION

PERMIT# REPAIR PIN# 4741-66-6585 DATE 9-9-03

OWNER OR CONTRACTOR JAMES D. LAMBERTH PHONE: Business Home 704-528-5512

ADDRESS 515 HOOVER ROAD, TROUTMAN, NC 28166

LOCATION US21 SOUTH, TL MURDOCK ROAD, TR HOOVER ROAD, 1.6 MILES ON LEFT AT BOX # 515

SUBDIVISION BLOCK / SECTION LOT 1 LOT AREA 3.85 ACRES SITE CLASS. PS DESIGN FLOW 360 L.T.A.R. EXISTING 0.3 GPD/SQ FT

Septic Tank: 1000 Gallons; STB 1007 Date 8-12-03
Pump Tank: Gallons; PT Date
Pump Make: Model Serial No.
Nitrification Field: No Fields 1 Square Feet 810 Linear Feet 270
No Lines THREE Trench Width 36" Max Trench Bottom Depth 36" Gravel Depth 18"

☐ New System ☑ Repair System Type: I (II) III, IV, V, VI
System Description:
Repair System Description: CONVENTIONAL, GRAVITY
Maintenance Agreement Required: ☐ Yes ☑ No


☐ House/Mod. Home No. Bedrooms 3
☑ Mobile Home No. Bathrooms 2
☐ Business No. Employees
☐ Other
☐ Slab ☑ Crawl Space ☐ Basement w/plumbing ☐ Basement wo/plumbing

Water Supply: ☑ Individual ☐ Public ☐ Community
WELL


Comments:/Conditions: INSTALL LINES AS FLAGGED AS CLOSE TO CONTOUR AS POSSIBLE USING 18" STONE

Comments:/Conditions: SEPTIC TANK WITH MARKER INSTALLED USING "TUFTITE" FILTER

INITIAL SITE SKETCH

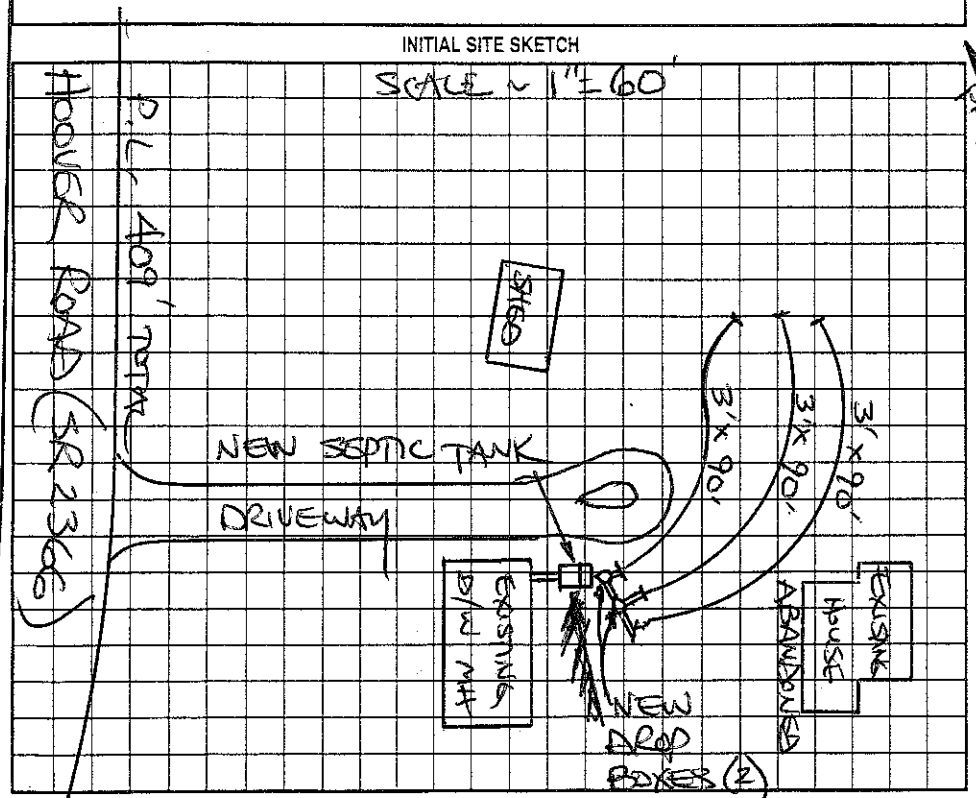


AS BUILT SKETCH

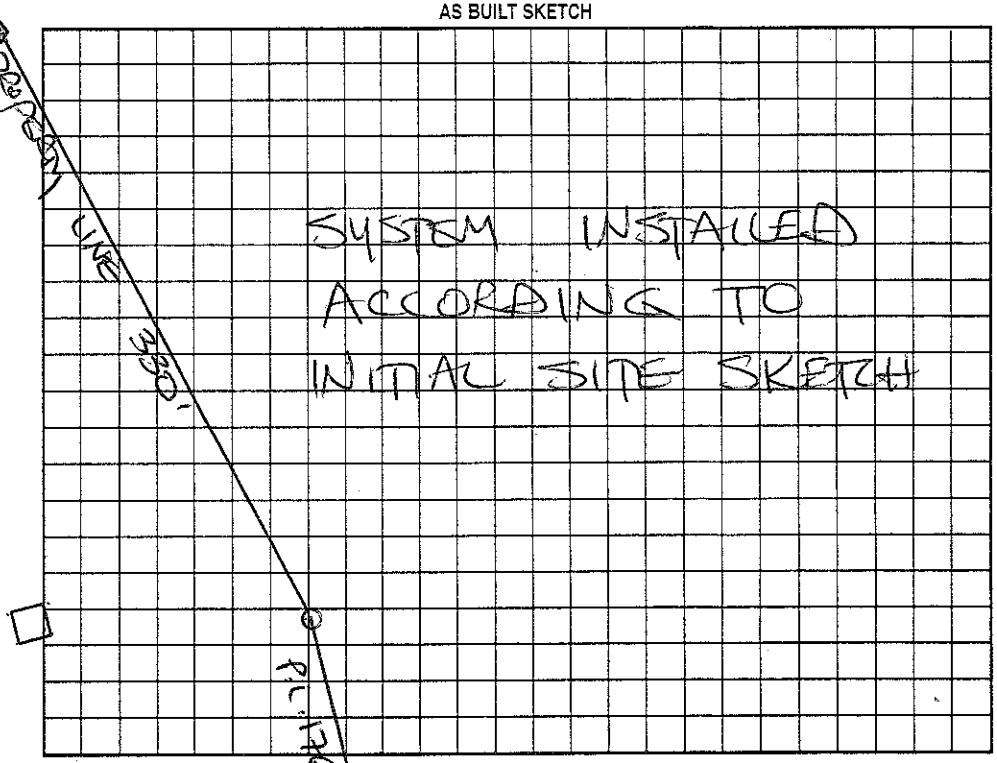


Permit can be suspended or revoked if any false information is supplied toward securing the permit/any unauthorized changes are made to the site/any unauthorized changes are made in the installation of the system. Improvement Permit with plat valid without expiration. Improvement Permit with site plan valid for sixty months. Authorization to Construct is valid for a period equal to that of Improvement Permit – not to exceed sixty months.

Signed: James D. Lamberth date 9-9-03

Improvement Permit by: STEVE HEDRICK date 9-9-03

Authorization to Construct by: STEVE HEDRICK date 9-9-03

Installed by: IREDELL BACKHOE

Operation Permit by: STEVE HEDRICK date 9-29-03

Existing System Inspection by: date

HEALTH DEPT. COPY: WHITE OWNER COPY (FINAL): YELLOW OWNER COPY (INITIAL): PINK