IREDELL COUNTY HEALTH DEPARTMENT

STATESVILLE 704-878-5305 MOORESVILLE 704-664-5281

IMPROVEMENT PERMIT / CERTIFICATE OF COMPLETION / OPERATION PERMIT / EXISTING SYSTEM INSPECTION

PROPERTY DESCRIPTION NO. Trantman DATE 6-23-97 TAX MAP NO. 4L - A - 78 Watershed: ☐ Yes ☐ No

OWNER OR CONTRACTOR David Gullet PHONE: Business 554-2275 Home 528 4942

ADDRESS 2549 Amity Hill Rd

LOCATION US 21 S to Murdock Rd TR Hoover Rd on Rt 1.0 mile Back on Rt 800'

SUBDIVISION _____ BLOCK / SECTION _____ LOT 5 LOT AREA 3.426 SITE CLASS. PS DESIGN FLOW 480 L.T.A.R. .3

Septic Tank: 1000 Gallons; STB 794 Date 2-3-97

Pump Tank: _____ Gallons; PT _____ Date _____

Pump Make: _____ Model _____ Serial No. _____

Nitrification Field: No Fields 1 Square Feet 1600 Linear Feet 533

No Lines 6 Trench Width 36" Max Trench Bottom Depth 34" Gravel Depth 12"

☑ New System ☐ Repair System Type: I, II, III, IV, V, VI

System Description: Conv. Gravity

Repair System Description: " " 11/Pump

Maintenance Agreement Required: ☐ Yes ☐ No

☑ House/Mod. Home No. Bedrooms 4

☐ Mobile Home No. Bathrooms 3

☐ Business No. Employees ____

☐ Other _____


☐ Slab ☐ Crawl Space ☐ Basement w/plumbing ☐ Basement wo/plumbing

Water Supply: ☑ Individual ☐ Community ☐ Public well


Comments:

Comments:

INITIAL SITE SKETCH

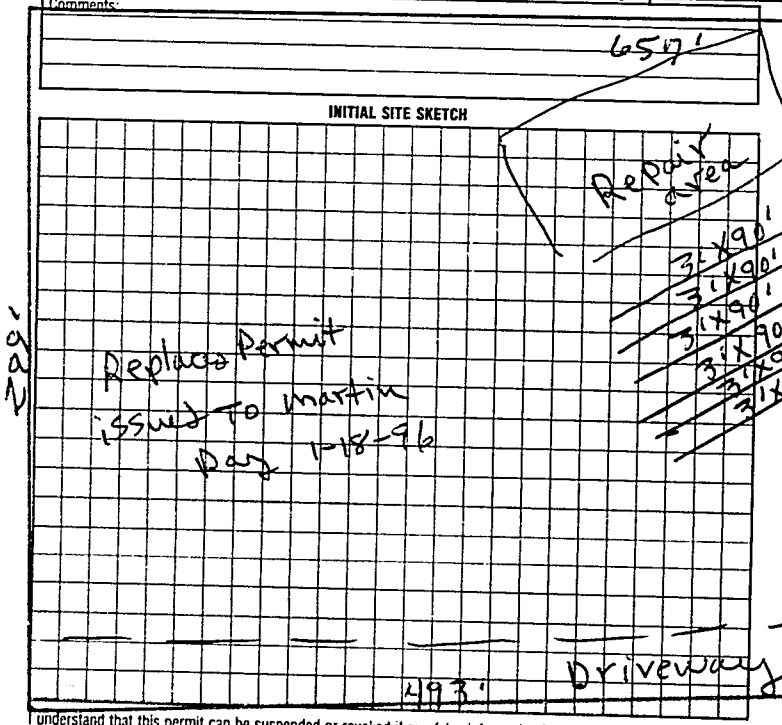

AS BUILT SKETCH

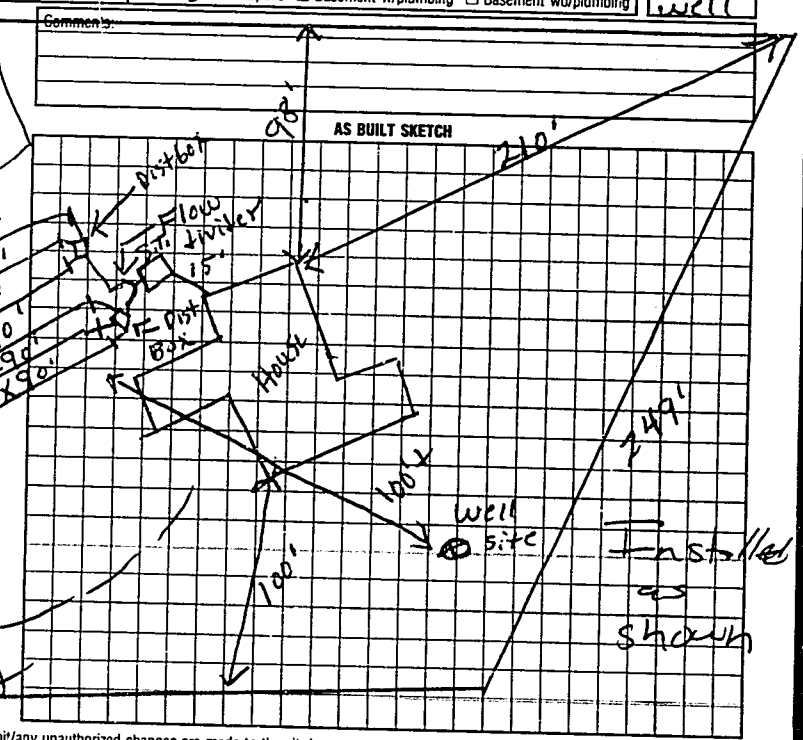

I understand that this permit can be suspended or revoked if any false information is supplied toward securing the permit/any unauthorized changes are made to the site/any unauthorized changes are made in the installation of the system. Improvement Permit is valid for 60 months from date of issuance.

Signed: Kathy A. Gullick

Improvement Permit by: R. C. Moore date 6-23-97

Existing System Inspection by: R. C. Moore date 6-23-97

Authorization to Count

Installed by: Larry Beam

Certificate of Completion by: _____ date _____

Operation Permit by: Mary Coffey RS date 7-1-97

Authorization to Count Expires 60 months from issue

HEALTH DEPT COPY WHITE INSPECTION COPY (FINAL) GREEN OWNER COPY (FINAL) YELLOW INSPECTION COPY (INITIAL) PINK OWNER COPY (INITIAL) GOLD