IREDELL COUNTY HEALTH DEPARTMENT

STATESVILLE 704-878-5305 MOORESVILLE 704-664-5281

IMPROVEMENT PERMIT / AUTHORIZATION TO CONSTRUCT / OPERATION PERMIT / EXISTING SYSTEM INSPECTION

PERMIT# X135117 PIN# 4741 68 1652 DATE May 8, 2006

OWNER OR APPLICANT Marc & Ursula Klinger PHONE: Business 704-995-3005 Home

ADDRESS 14610 S. Brent Dr., Huntersville, N.C. 28078 / 181 Scotsman Dr. Troutman

LOCATION From Statesville 21S - TR Murdock Rd. TR Hoover Rd. TR Scotsman Dr. to end bear right

SUBDIVISION BLOCK / SECTION LOT LOT AREA 12.954 ac SITE CLASS PS DESIGN FLOW 480gpd L.T.A.R. ~.3

Septic Tank: 1000 Gallons; STB 760 Date 4-30-07

Pump Tank: 1000 Gallons; PT 363 Date 6-10-07

Pump Make: Zoeller Model BN153-B Serial No.

Nitrification Field: No Fields 1 Square Feet 400 Linear Feet 134

No Lines 3+1 Ex-New Trench Width 36" Max Trench Bottom Depth 36" Gravel Depth 12"

☐ New System ☐ Repair ☒ Expansion System Type: I II III IV V VI CS

System Description: pump conventional

Repair System Description: p. conv.

Maintenance Agreement Required: ☐ Yes ☑ No

☒ House/Mod. Home ☐ Mobile Home ☐ Business ☐ Other

No. Bedrooms 4 No. Persons No. Employees


Water Supply: ☒ Individual ☐ Public ☐ Community

☐ Gravity ☑ Pressure ☐ Slab ☐ Crawl Space ☒ Basement w/plumbing ☐ Basement wo/plumbing


Comments:/Conditions: Check existing tank @ bern, pump as needed.
USE 90° Elbow on 2" supply line inside
Ex. tank @ bern.
Pump specs 29 gpm @ Approx. 31' TDH

Comments:/Conditions:

INITIAL SITE SKETCH

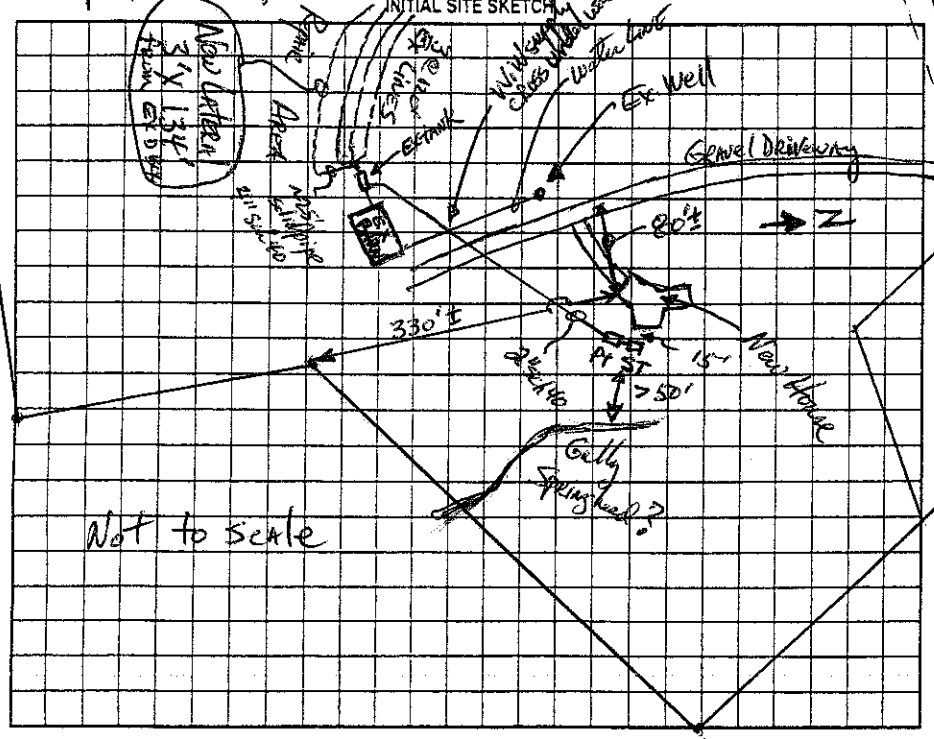

AS BUILT SKETCH

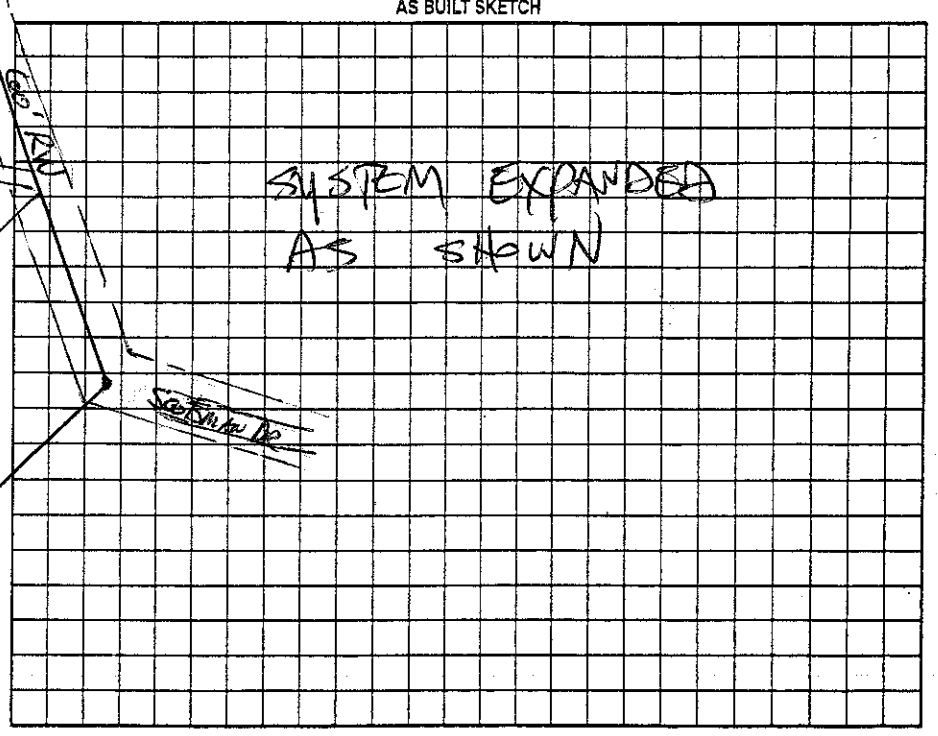

Permit can be suspended or revoked if any false information is supplied toward securing the permit/any unauthorized changes are made to the site/any unauthorized changes are made in the installation of the system. Improvement Permit with plat valid without expiration. ☐ Improvement Permit with site plan valid for sixty months ☒ Authorization to Construct is valid for a period equal to that of Improvement Permit – not to exceed sixty months.

Signed: date 6.15.06 Installed by: Sammy Davis

Improvement Permit by: date 5-8-06 Operation Permit by: date 12-6-07

Authorization to Construct by: date 5-8-06 Existing System Inspection by: date

HEALTH DEPT. COPY: WHITE OWNER COPY (FINAL): YELLOW OWNER COPY (INITIAL): PINK