# IREDELL COUNTY HEALTH DEPARTMENT

STATESVILLE 704-878-5305 MOORESVILLE 704-664-5281

3.00 56854

## IMPROVEMENT PERMIT / CERTIFICATE OF COMPLETION / OPERATION PERMIT / EXISTING SYSTEM INSPECTION

PROPERTY DESCRIPTION NO. Troutman DATE 6-26-95 TAX MAP NO. 1646 A2nC Watershed: ☐ Yes ☒ No

OWNER OR CONTRACTOR Darryl Brown PHONE: Business Home 568-0525

ADDRESS 1715 Shannon House Dr. Charlotte, N.C.

LOCATION I-77 TR Amity Hill TL Murdock Rd TR Hoovers Rd 1/2mi TR Private

SUBDIVISION BLOCK / SECTION LOT LOT AREA 1.5 acres SITE CLASS P3 DESIGN FLOW 360 L.T.A.R. .75 Dr.

Septic Tank: 1000 Gallons: STB 1017 Dat 3-23-96

Pump Tank: Gallons: PT Dat

Pump Make: Model Serial No

Nitrification Field: No Fields 1 Square Feet 1050 Linear Feet 360

No Lines 3 Trench Width 36" Max Trench Bottom Depth 36" Gravel Depth 12"

☐ New System ☐ Repair System Type: I, II, III, IV, V, VI

System Description: Conv. Gravity

Repair System Description: " "

Maintenance Agreement Required: ☐ Yes ☒ No

☒ House/Mod. Home No. Bedrooms 3

☐ Mobile Home No. Bathrooms 2½

☐ Business No. Employees

☐ Other


☐ Slab ☐ Crawl Space ☒ Basement w/plumbing ☐ Basement wo/plumbing

Water Supply: ☒ Individual ☐ Community ☒ Public


Comments:

Comments:

### INITIAL SITE SKETCH

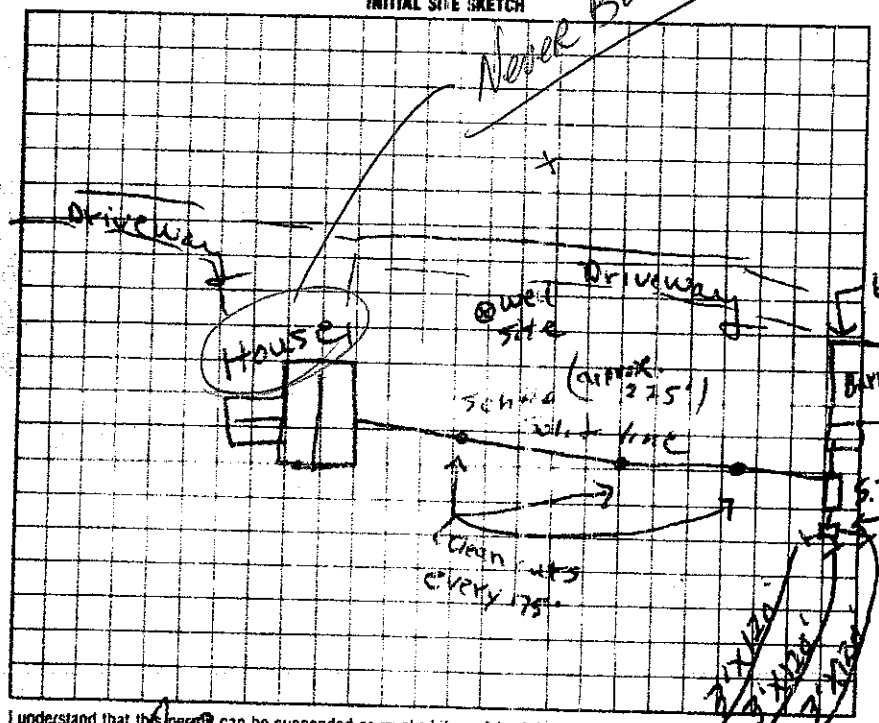


### AS BUILT SKETCH

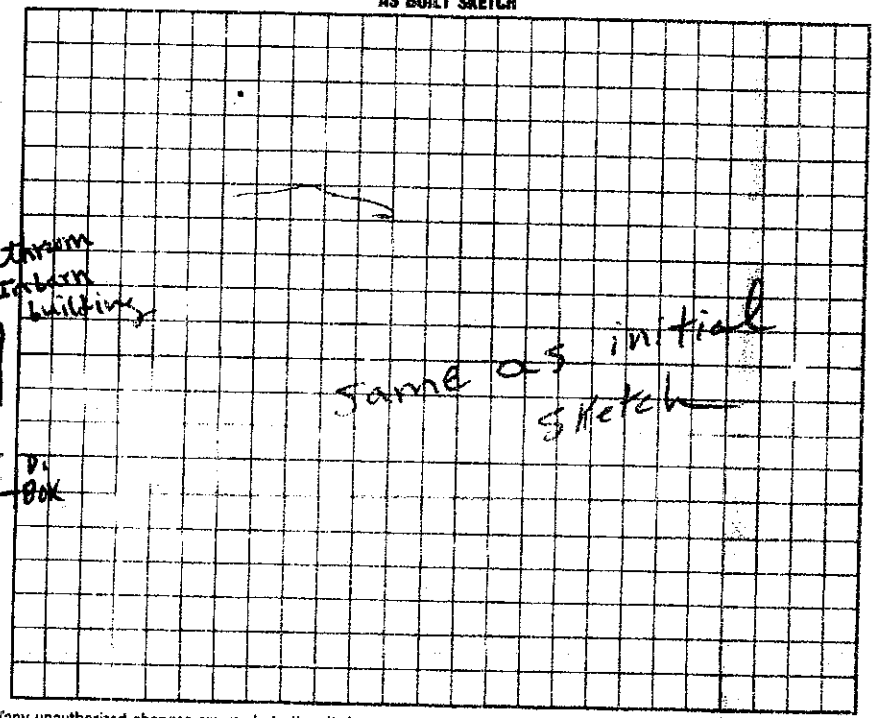


I understand that this permit can be suspended or revoked if any false information is supplied toward securing the permit/any unauthorized changes are made to the site/any unauthorized changes are made in the installation of the system. Improvement Permit is valid for 60 months from date of issuance

Signed: X

Improvement Permit by: P. C. Moore date 6-26-95

Existing System Inspection by date

Installed by: David Yount

Certificate of Completion by: date

Operation Permit by: P. C. Moore date 5-25-96

HEALTH DEPT. COPY: WHITE INSPECTION COPY (FINAL): GREEN OWNER COPY (FINAL): YELLOW INSPECTION COPY (INITIAL): PINK OWNER COPY (INITIAL): GOLD

JAN. 5, 1989 2:47