Margaret Bush Pd #150. 6/25/96

4741-73-0331

61695

IREDELL COUNTY HEALTH DEPARTMENT

STATESVILLE 704-878-5305 MOORESVILLE 704-664-5281

IMPROVEMENT PERMIT / CERTIFICATE OF COMPLETION / OPERATION PERMIT / EXISTING SYSTEM INSPECTION

PROPERTY DESCRIPTION NO. 23736 DATE 5-16-96 TAX MAP NO. 46-1-A-5 Watershed: ☐ Yes ☐ No

OWNER OR CONTRACTOR Tony D. Owens PHONE: Business Home 704-278-1434

ADDRESS 13945 Statesville Blvd Cleveland N.C.

LOCATION US 21 S TL Perry Rd at Troutman 2mi TR Levo Ln 1/4mi left

SUBDIVISION Perry Heights BLOCK / SECTION LOT 5 LOT AREA 1.15 acres SITE CLASS. PS DESIGN FLOW 360 L.T.A.R. .28

Septic Tank: 1000 Gallons; STB 1012 Date 7-6-96

Pump Tank: 1000 Gallons; PT 169 Date 8-12-96

Pump Make: Liberty Model 61-A Serial No. [redacted]8193

Nitrification Field: No Fields 1 Square Feet 375 Linear Feet 425

No Lines 5 Trench Width 36" Max Trench Bottom Depth 36" Gravel Depth 12"

☐ New System ☐ Repair System Type: I. II (III) IV. V. VI

System Description: Pump To Conv. Lines

Repair System Description: " " " "

Maintenance Agreement Required: ☐ Yes ☒ No

☒ House/Mod. Home No. Bedrooms 3

☐ Mobile Home No. Bathrooms 2

☐ Business No. Employees

☐ Other

☐ Slab ☒ Crawl Space ☐ Basement w/plumbing ☐ Basement wo/plumbing

Water Supply: ☒ Individual ☐ Community ☐ Public


Comments: See Attached Sheets For Pump Tank & Pressure manifold Set up

⊗ well Next door


Comments: Check S.T. P.T. Drain Lines Pressure manifold Did Pump draw down @ 10-16-96 JCM

415.48'

INITIAL SITE SKETCH

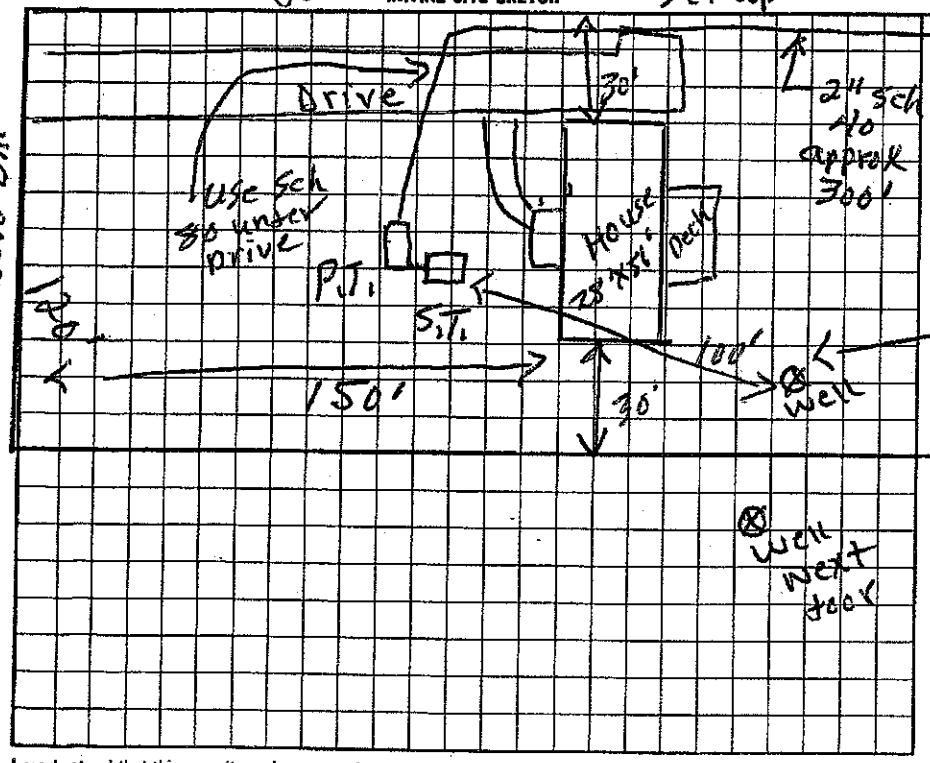

AS BUILT SKETCH

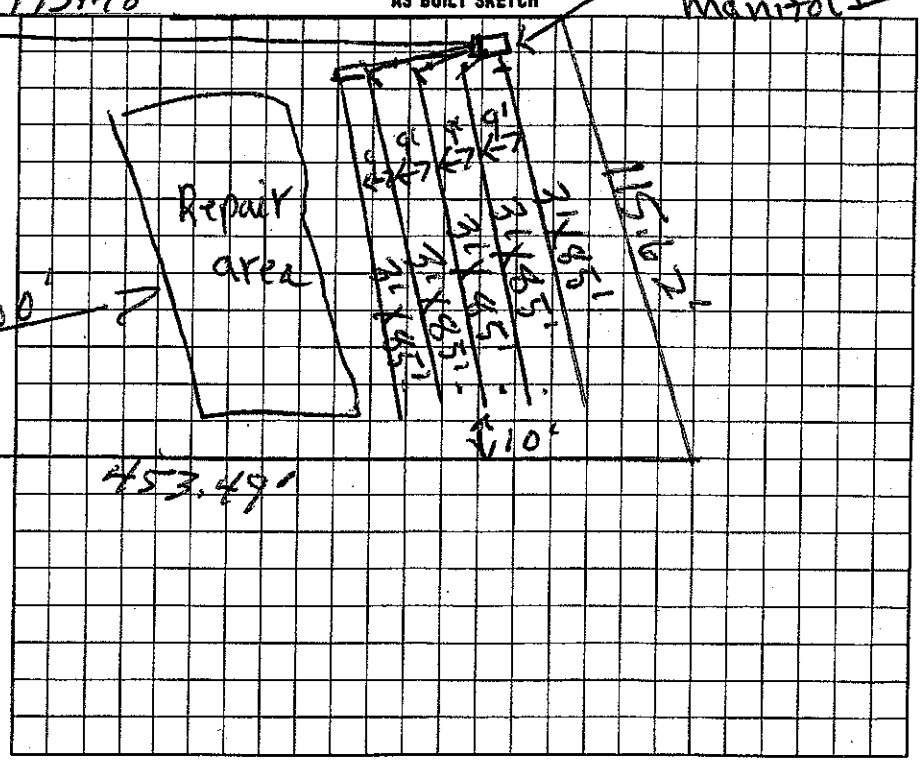

I understand that this permit can be suspended or revoked if any false information is supplied toward securing the permit/any unauthorized changes are made to the site/any unauthorized changes are made in the installation of the system.

Signed: Carla Owens

Improvement Permit by: J. C. Moore date 5-16-96

Authorization to Construct

Existing System Inspection by: J. C. Moore date 5-16-96

Installed by: BARRY SIGMON

Certificate of Completion by: NOT FINALED - RSH 12/8/2010 date

Operation Permit by: date

HEALTH DEPT. COPY: WHITE INSPECTION COPY (FINAL): GREEN OWNER COPY (FINAL): YELLOW INSPECTION COPY (INITIAL): PINK OWNER COPY (INITIAL): GOLD

Authorization to Const EXPIRES 6 mos from issue