IREDELL COUNTY HEALTH DEPARTMENT

Statesville Office (704) 878-5305 Mooresville Office (704) 660-3625 PERMIT # 22532

IMPROVEMENT PERMIT / AUTHORIZATION TO CONSTRUCT / OPERATION PERMIT / EXISTING SYSTEM

PIN # 4741730331

APPLICANT: Larry Munday APPLICANT ADDRESS: 673 Shiloh Rd Statesville NC 28677

SITE ADDRESS: 131 Levo Rd. Troutman NC 28166 PHONE: 704-872-6019 ALT. PHONE: 704-902-1479

SITE DIRECTIONS: 21 S to Ostwalt Amity T/C Perry Rd T/C Levo Lot on Lft

SUBDIVISION: Perry Heights SECTION: N/A LOT # 5 LOT AREA: 1.15ac DESIGN FLOW: 360 L.T.A.R.: Ex

Septic Tank	Ex (gal)	STB	Date				
Pump Tank	(gal)	PT	Date				
Pump Make	Model		Serial #				
# Nitrification Fields	Ex # Lines	Ex	Linear Ft:	Ex			
Trench Width	Ex Max. Trench Bottom Depth	Ex	Gravel Depth	Ex			

☐ New System ☐ Repair ☐ Expansion System Type: I II III IV V VI

System Description: Existing

Repair System Description:

Maintenance Agreement Required: ☐ YES ☒ NO ☐ GRAVITY ☑ PRESSURE

☒ Residence ☐ Business ☐ Other ☐ Slab ☐ Basement w/plumbing


No. Bedrooms 3 No. Persons 6 No. Employees ☒ Crawl Space

Water Supply: ☒ Private ☐ Public ☐ Community


☐ Basement w/o plumbing

Comments / Conditions: maintain 5' off any part of STS
Permit on hold untill Pressure test and alarm final can be performed.

INITIAL SITE SKETCH

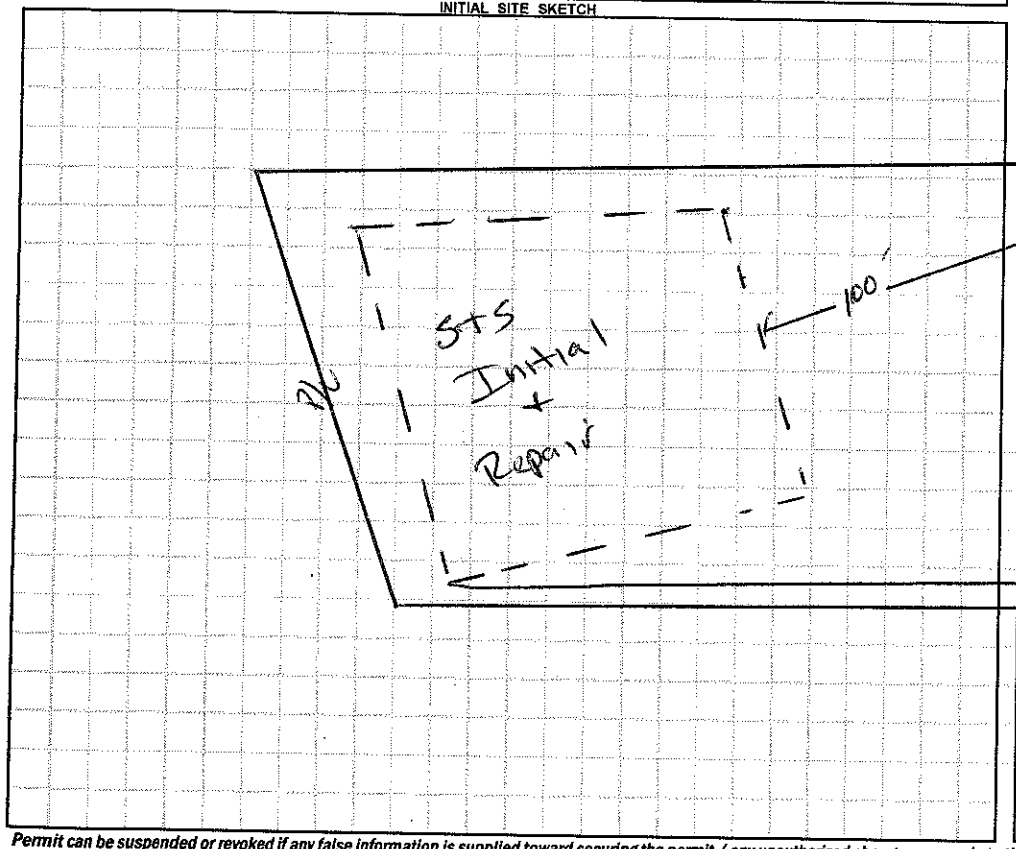

AS BUILT SKETCH

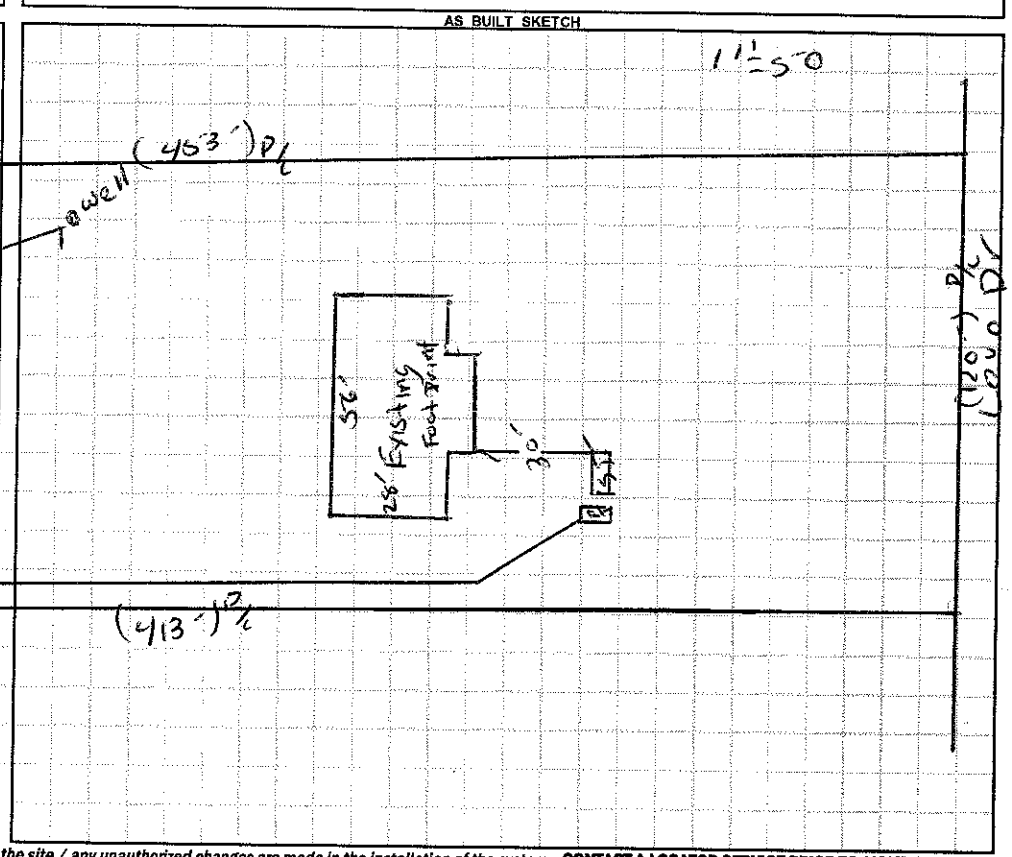

Permit can be suspended or revoked if any false information is supplied toward securing the permit / any unauthorized changes are made to the site / any unauthorized changes are made in the installation of the system. **CONTACT A LOCATOR SERVICE PRIOR TO ANY EXCAVATION**

☐ **IMPROVEMENT PERMIT** *with plat valid without expiration.* ☐ **IMPROVEMENT PERMIT** *with site plan valid for 60 mos.* ☐ **AUTHORIZATION TO CONSTRUCT** *valid for period equal to IMPROVEMENT PERMIT--not to exceed 60 mo.*

Owner / Applicant Signature: Larry Munday Date: 3-31-17 Installed by:

IMPROVEMENT PERMIT by: Date: OPERATION PERMIT by: Date:

AUTHORIZATION TO CONSTRUCT by: Date: Existing System Inspected by: Date: 03/27/17

Health Dept. Copy - WHITE Applicant (Final Approval) - YELLOW Applicant (Conditional Approval) - PINK