# IREDELL COUNTY HEALTH DEPARTMENT

STATESVILLE 704-878-5305 MOORESVILLE 704-664-5281

## IMPROVEMENT PERMIT / CERTIFICATE OF COMPLETION / OPERATION PERMIT / EXISTING SYSTEM INSPECTION

PROPERTY DESCRIPTION NO. _____ DATE 2-10-95 TAX MAP NO. _____ Watershed: ☐ Yes ☑ No

OWNER OR CONTRACTOR Steve Horney PHONE: Business _____ Home 528-6400

ADDRESS 119 Levo Rd Troutman

LOCATION US 21 S to Troutman IL Perry Rd TR Levo 2nd Hse left

SUBDIVISION Perry Park BLOCK / SECTION _____ LOT 3 LOT AREA 3/4 acre SITE CLASS PS DESIGN FLOW 360 L.T.A.R. .13

Septic Tank: 2 X Gallons; STB _____ Date _____

Pump Tank: 1000 Gallons; PT _____ Date _____

Pump Make: _____ Model _____ Serial No. _____

Nitrification Field: No Fields 1 Square Feet 1200 Linear Feet 400

No Lines 5 Trench Width 36" Max Trench Bottom Depth 36" Gravel Depth 12"

☐ New System ☑ Repair System Type: I, II, III, IV, V, VI

System Description: _____

Repair System Description: Pump to conv lines

Maintenance Agreement Required: ☐ Yes ☐ No

☑ House/Mod. Home No. Bedrooms 3

☐ Mobile Home No. Bathrooms 2

☐ Business No. Employees _____

☐ Other _____


☐ Slab ☐ Crawl Space ☐ Basement w/plumbing ☐ Basement wo/plumbing

Water Supply: ☑ Individual ☐ Community ☐ Public

Comments:

option 1 Pump to back yard as shown
option 2 Drop down to Front yard as shown Gravity Feed with 18" stone


INITIAL SITE SKETCH

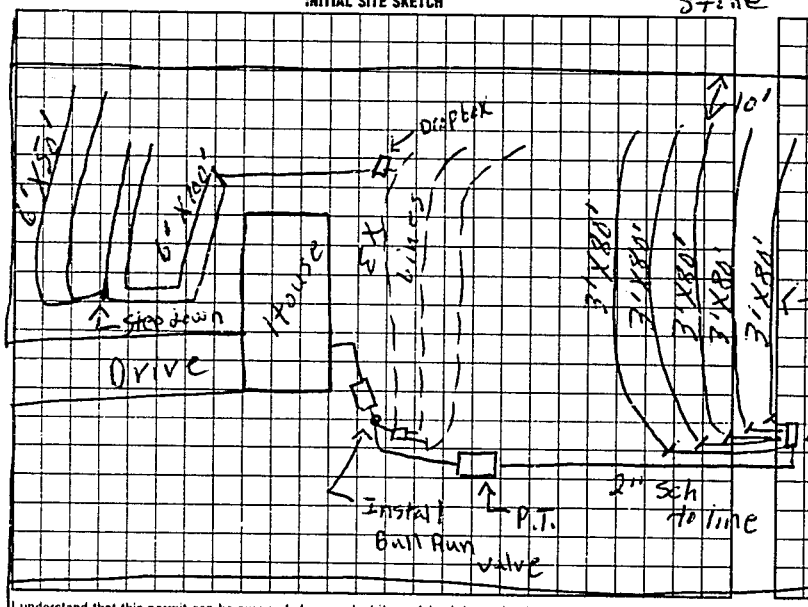


Comments:

Gravity Field Placed In back
Plumbing leaks were Fixed
6' X 80' Field Installed

AS BUILT SKETCH

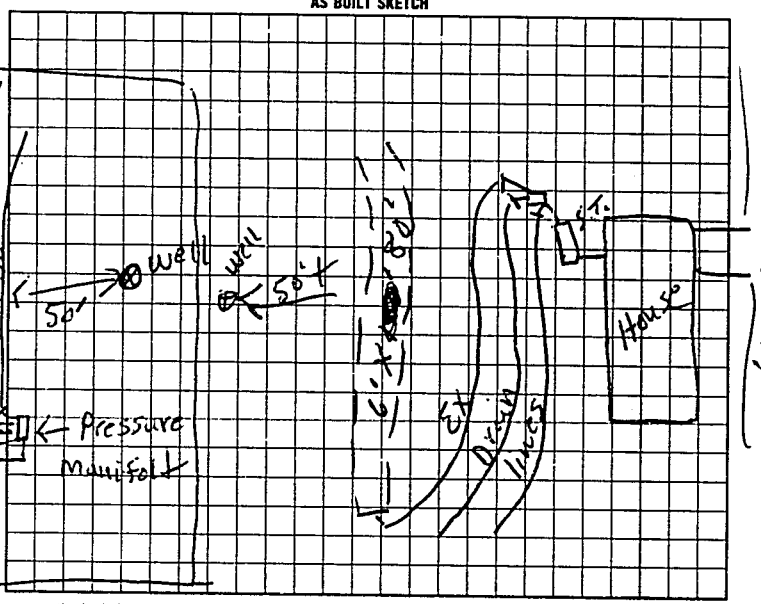


I understand that this permit can be suspended or revoked if any false information is supplied toward securing the permit/any unauthorized changes are made to the site/any unauthorized changes are made in the installation of the system. Improvement Permit is valid for 60 months from date of issuance.

Signed: Robin Horney

Improvement Permit by: F.C. Moore date 2-10-95

Existing System Inspection by: _____ date _____

Installed by: Tim Ammons

Certificate of Completion by: F.C. Moore date 5-9-95

Operation Permit by: _____ date _____

HEALTH DEPT. COPY: WHITE INSPECTION COPY (FINAL): GREEN OWNER COPY (FINAL): YELLOW INSPECTION COPY (INITIAL): PINK OWNER COPY (INITIAL): GOLD

97000