(Marty Tucker) - 3:00

IREDELL COUNTY HEALTH DEPARTMENT

STATESVILLE 704-878-5305 MOORESVILLE 704-664-5281

IMPROVEMENT PERMIT / AUTHORIZATION TO CONSTRUCT / OPERATION PERMIT / EXISTING SYSTEM INSPECTION

PERMIT# 091317 PIN# 4741747423 DATE August 16, 00

OWNER OR CONTRACTOR Kelly Smith PHONE: Business 528-4129 Home

ADDRESS 719 Perry Rd. Troutman

LOCATION 115 S. to Perry Rd ~1/2 miles on left 500-1000 ft off Road (look for Red Barn Mailbox)

SUBDIVISION BLOCK / SECTION LOT LOT AREA 8.69 Ac SITE CLASS. PS DESIGN FLOW 360gpd L.T.A.R. ~.25

Septic Tank: Existing Gallons: STB Date

Pump Tank: Gallons: PT Date

Pump Make: Model Serial No.

Nitrification Field: No Fields 1+EX Square Feet 600 Linear Feet 200

No Lines 2 Trench Width 36" Max Trench Bottom Depth 36" Gravel Depth 12"

[X] New System [ ] Repair System Type: I. II. III. IV. V. VI

System Description: gravity conventional upgrade

Repair System Description: gravity pumped conventional

Maintenance Agreement Required? [ ] Yes [X] No

[X] House/Mod. Home No. Bedrooms 3

[ ] Mobile Home No. Bathrooms 2

[ ] Business No. Employees

[ ] Other

[ ] Slab [X] Crawl Space [ ] Basement w/plumbing [ ] Basement wo/plumbing


Water Supply: [X] Individual [ ] Public [ ] Community

Comments/Conditions: Single Wide Mobile home to be Removed once DW/Modular is Completed.


Upgrade to 3 Bedroom Capacity

Comments/Conditions

INITIAL SITE SKETCH

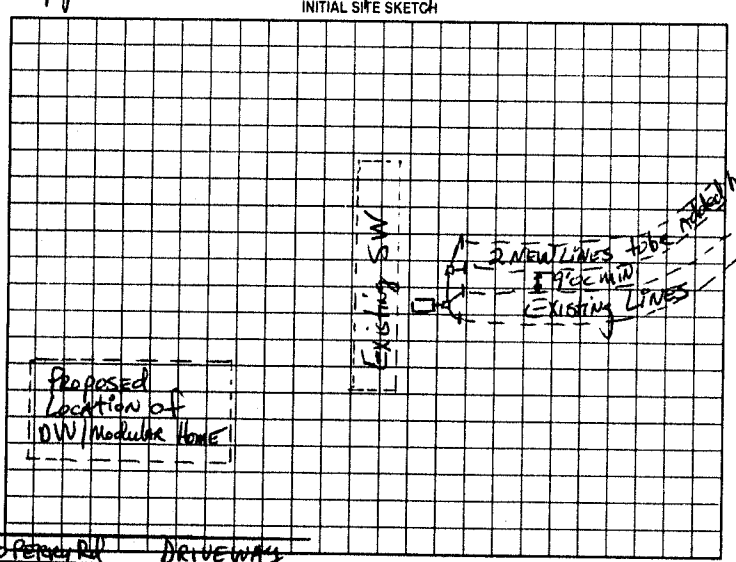

AS BUILT SKETCH

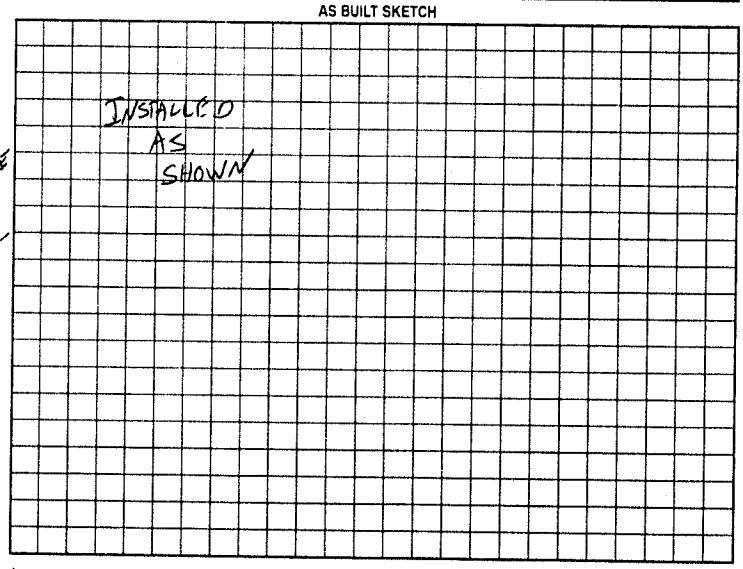

Permit can be suspended or revoked if any false information is supplied toward securing the permit/any unauthorized changes are made to the site/any unauthorized changes are made in the installation of the system. Improvement Permit with plat valid without expiration. Improvement Permit with site plan valid for sixty months. Authorization to Construct is valid for a period equal to that of Improvement Permit – not to exceed sixty months.

Signed: date

Improvement Permit by: date 8-16-00

Authorization to Construct by: date 8-16-00

Installed by: MARTY TUCKER

Operation Permit by: date 8/24/00

Existing System Inspection by: date

HEALTH DEPT. COPY: WHITE OWNER COPY (FINAL): YELLOW OWNER COPY (INITIAL): PINK