IREDELL COUNTY HEALTH DEPARTMENT

STATESVILLE 704-878-5305 MOORESVILLE 704-664-5281

IMPROVEMENT PERMIT / AUTHORIZATION TO CONSTRUCT / OPERATION PERMIT / EXISTING SYSTEM INSPECTION

PERMIT# REPAIR PIN# 4741-77-1432 DATE 1-3-03

OWNER OR CONTRACTOR KENNY R SLONE PHONE: Business 704-382-4357 Home 704-528-3940

ADDRESS P.O. BOX 1257, TROUTMAN, NC 28166

LOCATION US 21 SOUTH, TL MURDOCK ROAD T/R HOOVER RD, ~1.1 MILE ON RIGHT

SUBDIVISION _____ BLOCK / SECTION _____ LOT _____ LOT AREA 2.61 ACRES SITE CLASS: PS DESIGN FLOW 480 L.T.A.R. EXISTING

Septic Tank EXISTING Gallons: STB _____ Date _____

Pump Tank: _____ Gallons: PT _____ Date _____

Pump Make: _____ Model _____ Serial No. _____

Nitrification Field: No Fields 1 Square Feet 600 Linear Feet 200

No Lines TWO Trench Width 36" Max Trench Bottom Depth AS SHALLOW AS POSSIBLE Gravel Depth 18"

☐ New System ☑ Repair System Type: (II) III, IV, V, VI

System Description: _____

Repair System Description: CONVENTIONAL, GRAVITY

Maintenance Agreement Required: ☐ Yes ☑ No

☑ House/Mod. Home No. Bedrooms 4

☐ Mobile Home No. Bathrooms 3

☐ Business No. Employees _____

☐ Other _____


☐ Slab ☐ Crawl Space ☑ Basement w/plumbing ☐ Basement wo/plumbing

Water Supply: ☑ Individual ☐ Public ☐ Community WELL


Comments/Conditions: ① INSTALL NEW DRAINLINES AS SHOWN USING 18 INCHES ② THIS PERMIT SERVES AS "NOTICE OF VIOLATION" SYSTEM TO BE REPAIRED BY FEBRUARY 3, 2003

Comments/Conditions:

INITIAL SITE SKETCH

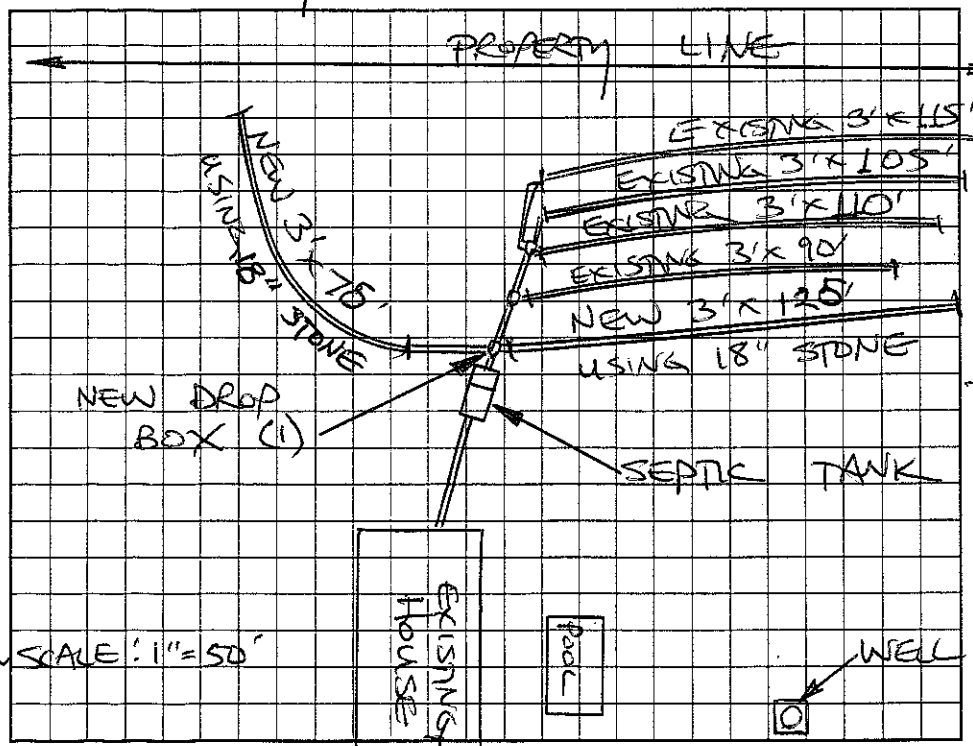

AS BUILT SKETCH

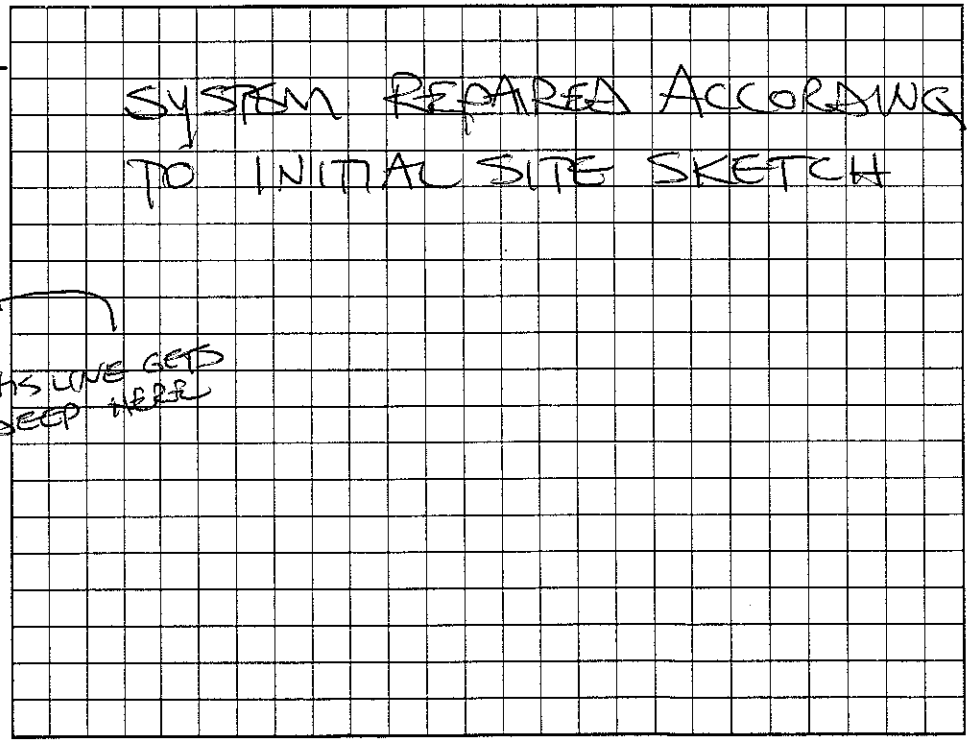

Permit can be suspended or revoked if any false information is supplied toward securing the permit/any unauthorized changes are made to the site/any unauthorized changes are made in the installation of the system. Improvement Permit with plat valid without expiration. Improvement Permit with site plan valid for sixty months. Authorization to Construct is valid for a period equal to that of Improvement Permit – not to exceed sixty months.

Signed: x Kenny R Slone date 1/3/3

Improvement Permit by: STEVE HEDRICK date 1-3-03

Authorization to Construct by: STEVE HEDRICK date 1-3-03

DRIVEWAY

Installed by: JAMES HUDLER

Operation Permit by: STEVE HEDRICK date 1-7-03

Existing System Inspection by: _____ date _____

HEALTH DEPT. COPY: WHITE OWNER COPY (FINAL): YELLOW OWNER COPY (INITIAL): PINK