*THIS PERMIT VOIDS PERMIT ISSUED ON 07/31/01.

IREDELL COUNTY HEALTH DEPARTMENT

STATESVILLE 704-878-5305 MOORESVILLE 704-664-5281

IMPROVEMENT PERMIT / AUTHORIZATION TO CONSTRUCT / OPERATION PERMIT / EXISTING SYSTEM INSPECTION

PERMIT# 100688 PIN# ~~4741-78-8148~~ 4741-77-4879 DATE 12/30/02

OWNER OR CONTRACTOR WILLIAM BREWSTER PHONE: Business 704-895-0556 Home

ADDRESS P.O. BOX 99 DAVIDSON, NC 28036

LOCATION MURDOCK RD, (L) HOOVER RD, 4th LOT ON LEFT, PAST MARTHAS VINEYARD

SUBDIVISION MARTHAS VINEYARD BLOCK / SECTION 1 LOT 45 LOT AREA 1.92 ACRES SITE CLASS. PS DESIGN FLOW 480 GPD L.T.A.R. 0.25 GPD/FT²

Septic Tank: 1,000 Gallons; STB 1012 Date 8-11-02

Pump Tank: 1,000 Gallons; PT Date 1-21-03

Pump Make: Goulds Model WE03111M Serial No. 4119411

Nitrification Field: No Fields 1 Square Feet EQ to 1920 Linear Feet 320

No Lines 8 @ 40' Trench Width 24" Max Trench Bottom Depth 36" Gravel Depth N/A

[X] New System [ ] Repair System Type: I, II, III, IV, V, VI

System Description: PUMP, 50% REDUCTION

Repair System Description: LOW PRESSURE, 50% Red.

Maintenance Agreement Required: [ ] Yes [X] No

[X] House/Mod. Home [ ] Mobile Home [ ] Business [ ] Other

No. Bedrooms 4 No. Bathrooms 3 No. Employees


[ ] Slab [ ] Crawl Space [ ] Basement w/plumbing [ ] Basement wo/plumbing

Water Supply: [X] Individual [ ] Public [ ] Community WELL


Comments/Conditions: (1) INSTALL SYSTEM USING 9 PANELS PER LINE, (72 PANELS TOTAL) (2) SEE ATTACHED SHEETS FOR

Comments/Conditions: → PUMP & PRESSURE MANIFOLD INFO. 3/28/03
- Tuff-Tite filter, ST marker installed, Lines OKay

INITIAL SITE SKETCH

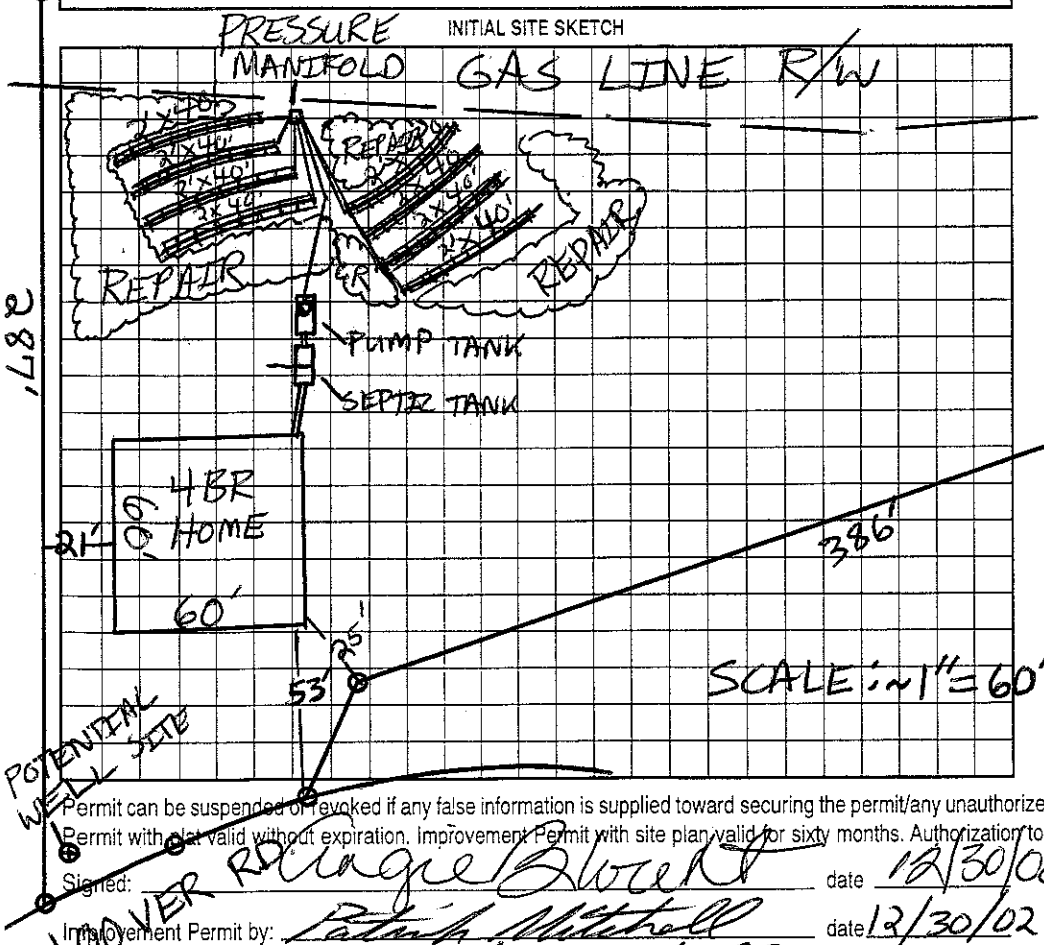

AS BUILT SKETCH

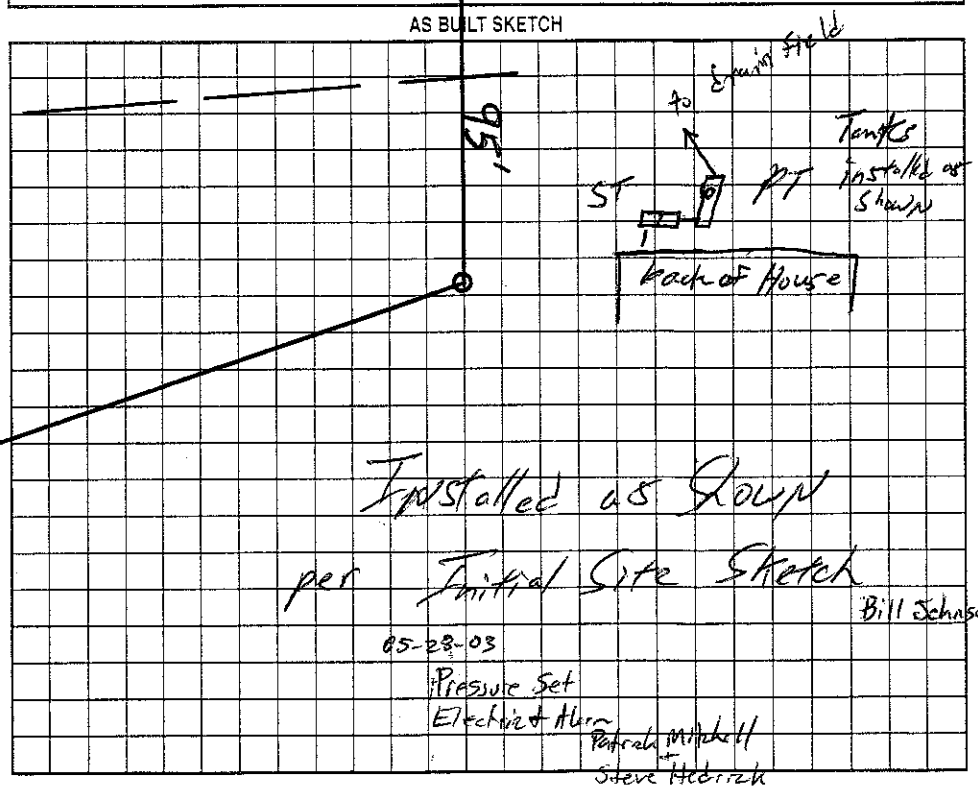

Permit can be suspended or revoked if any false information is supplied toward securing the permit/any unauthorized changes are made to the site/any unauthorized changes are made in the installation of the system. Improvement Permit with plat valid without expiration. Improvement Permit with site plan valid for sixty months. Authorization to Construct is valid for a period equal to that of Improvement Permit – not to exceed sixty months.

Signed: Roger Brewster date 12/30/02 Installed by: A1 Backhoe (3/28/03)

Improvement Permit by: Patrick Mitchell date 12/30/02 Operation Permit by: Patrick Mitchell date 05/28/03

Authorization to Construct by: Patrick Mitchell date 12/30/02 Existing System Inspection by: date

HEALTH DEPT. COPY: WHITE OWNER COPY (FINAL): YELLOW OWNER COPY (INITIAL): PINK