IREDELL COUNTY HEALTH DEPARTMENT

STATESVILLE 704-878-5305 MOORESVILLE 704-664-5281

IMPROVEMENT PERMIT / AUTHORIZATION TO CONSTRUCT / OPERATION PERMIT / EXISTING SYSTEM INSPECTION

PERMIT# 100673 PIN# 4741 ~~78 8148 PF~~ 77-8529 DATE 7/27/01

OWNER OR CONTRACTOR WILLIAM BREWSTER PHONE: Business 895-0556 Home

ADDRESS PO BOX 99 DAVIDSON NC 28036

LOCATION 21S - TL MURDOCK - TR HOOVER - TL MARTHAS VINEYARD - TR PAINTED BUNTING - ON RT

SUBDIVISION MARTHAS VINEYARD BLOCK / SECTION LOT 30 LOT AREA 30.96 SITE CLASS. PS DESIGN FLOW 360 GPD L.T.A.R. .3600/FT2

Septic Tank: 1000 Gallons; STB 10/2 Date 12-20-02

Pump Tank: 1000 Gallons; PT 17 Date

Pump Make: Gould's Model WE05HH Serial No. E0365271

Nitrification Field: No Fields 1 Square Feet 420 Linear Feet 210

No Lines 3@70' Trench Width 24" Max Trench Bottom Depth 36" Gravel Depth N/A

☑ New System ☐ Repair System Type: I, II, III, IV, V, VI

System Description: LP PANEL

Repair System Description: SAME

Maintenance Agreement Required: ☑ Yes ☐ No

☑ House/Mod. Home No. Bedrooms 3

☐ Mobile Home No. Bathrooms 3

☐ Business No. Employees

☐ Other

☐ Slab ☑ Crawl Space ☐ Basement w/plumbing ☐ Basement wo/plumbing


Water Supply: ☑ Individual ☐ Public ☐ Community

Comments:/Conditions:


*TOLD THEM IT WAS OKAY TO MOVE TANKS TO OTHER FRONT HOME CORNER & TO RUN SUPPLY LINE & VALVE BOX UP OPPOSITE SIDE. P. Mitchell 7-07-03 *

Comments:/Conditions: Tuff Tite Sl/Tar & ST Marker Installed - Sim-Tech Filter Installed Pump Tank (48 panels Installed) Lines Okay, 78-03 Lof 1 Pressure Check Electrical & Alarm Check Per Pm

INITIAL SITE SKETCH 1" = 50'

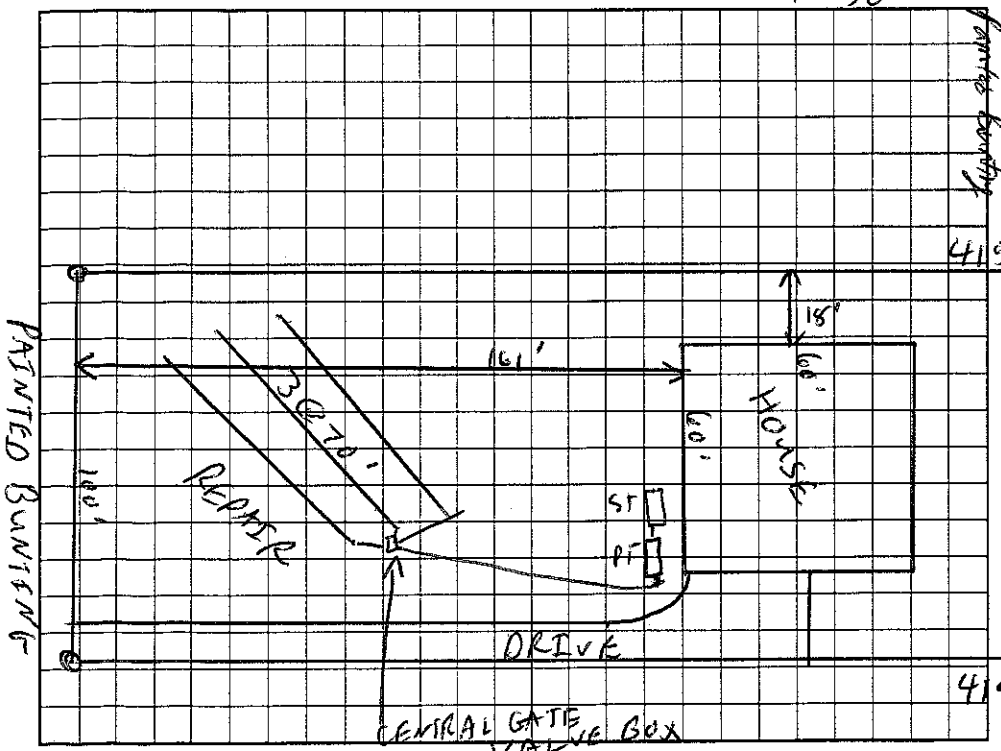

AS BUILT SKETCH 1" = 100'

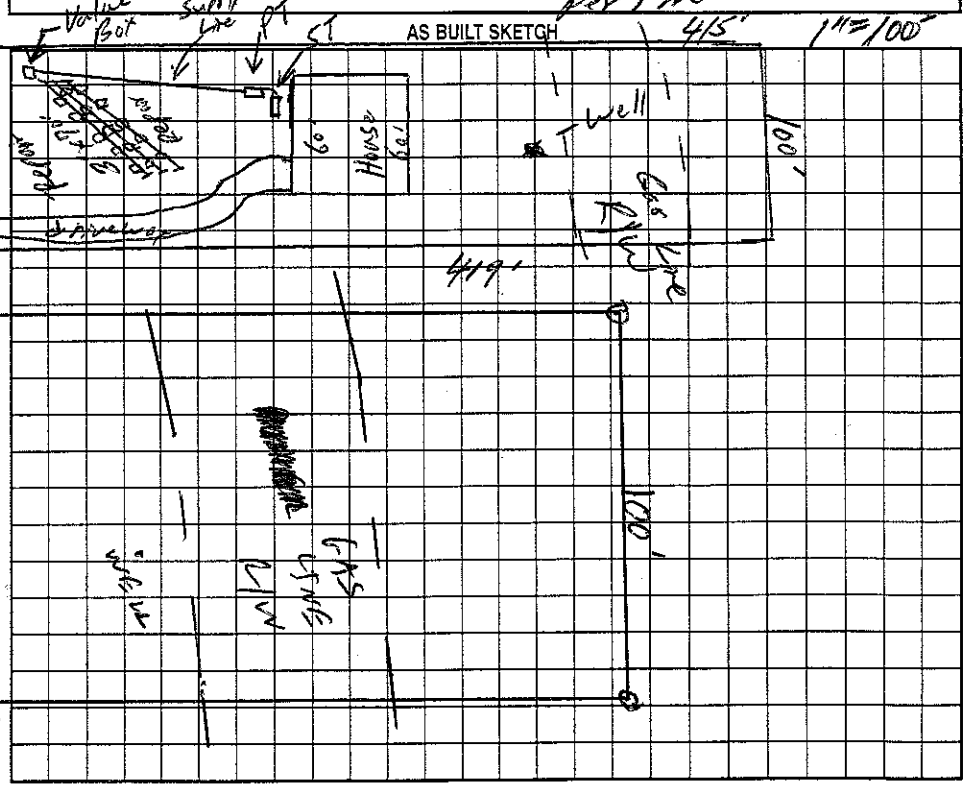

Permit can be suspended or revoked if any false information is supplied toward securing the permit/any unauthorized changes are made to the site/any unauthorized changes are made in the installation of the system. Improvement Permit with plat valid without expiration. Improvement Permit with site plan valid for sixty months. Authorization to Construct is valid for a period equal to that of Improvement Permit – not to exceed sixty months.

Signed: date 10/8/02 Installed by: A-1 Backhoe (7/8/03)

Improvement Permit by: C. [illegible] RS date 7/27/01 Operation Permit by: William C. Johnson date 8/22/03

Authorization to Construct by: Patrick Mitchell date 10/09/02 Existing System Inspection by: date

HEALTH DEPT. COPY: WHITE OWNER COPY (FINAL): YELLOW OWNER COPY (INITIAL): PINK