IREDELL COUNTY HEALTH DEPARTMENT

STATESVILLE 704-878-5305 MOORESVILLE 704-664-5281

IMPROVEMENT PERMIT / AUTHORIZATION TO CONSTRUCT / OPERATION PERMIT / EXISTING SYSTEM INSPECTION

PERMIT# 100673 PIN# 4741 ~~78 8145 PT~~ 77-8529 DATE 7/27/01

OWNER OR CONTRACTOR WILLIAM BREWSTER PHONE: Business 895-0556 Home

ADDRESS PO BOX 99 DAVIDSON NC 28036

LOCATION 215 - TL MURDOCK - TR HOOVER - TL MARTHAS VINEYARD - TR PAINTED BUNTING - ON RT

SUBDIVISION MARTHAS VINEYARD BLOCK / SECTION LOT 30 LOT AREA .96 SITE CLASS B5 DESIGN FLOW 360 GPD L.T.A.R. .360/FT2

Septic Tank: 1000 Gallons; STB 10/2 Date 12-20-02
Pump Tank: 1000 Gallons; PT 17 Date
Pump Make: Gould's Model WE05HH Serial No. K0365271
Nitrification Field: No Fields 1 Square Feet 420 Linear Feet 210
No Lines 3@70' Trench Width 24" Max Trench Bottom Depth 36" Gravel Depth N/A

☑ New System ☐ Repair System Type: I, II, III, (IV) V, VI
System Description: LP PANEL
Repair System Description: SAME
Maintenance Agreement Required: ☑ Yes ☐ No

☑ House/Mod. Home No. Bedrooms 3
☐ Mobile Home No. Bathrooms 3
☐ Business No. Employees
☐ Other

☐ Slab ☑ Crawl Space ☐ Basement w/plumbing ☐ Basement wo/plumbing


Water Supply: ☑ Individual ☐ Public ☐ Community

Comments:/Conditions:


TOLD THEM IT WAS OKAY TO MOVE TANKS TO OTHER FRONT HOME CORNER + TO RUN SUPPLY LINE + VALVE BOX UP OPPSITE SIDE, P. Mitchell 7-07-03

Comments:/Conditions: TUFF Tite Filter + ST Marker Installed - Sim-Tech Filter Installed in Pump Tank (48 panels Installed) Lines Okay, 7803 Lgl 1 Pressure Check Electrical + Alarm Check Per Fm

INITIAL SITE SKETCH 1" = 50'

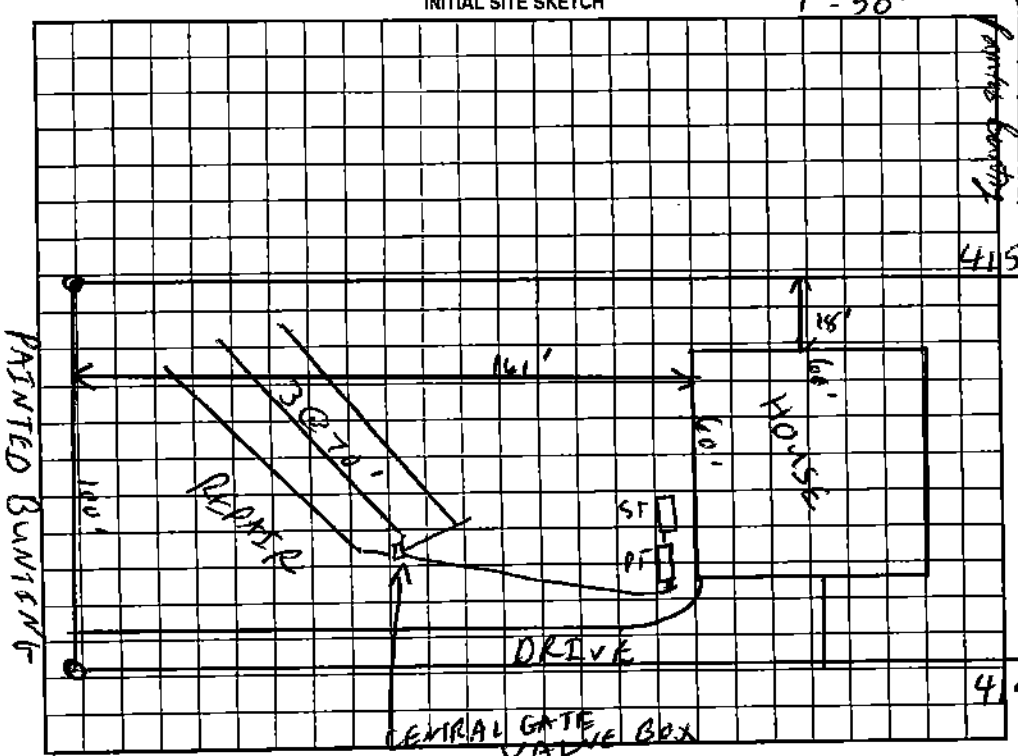

AS BUILT SKETCH 415' 1" = 100'

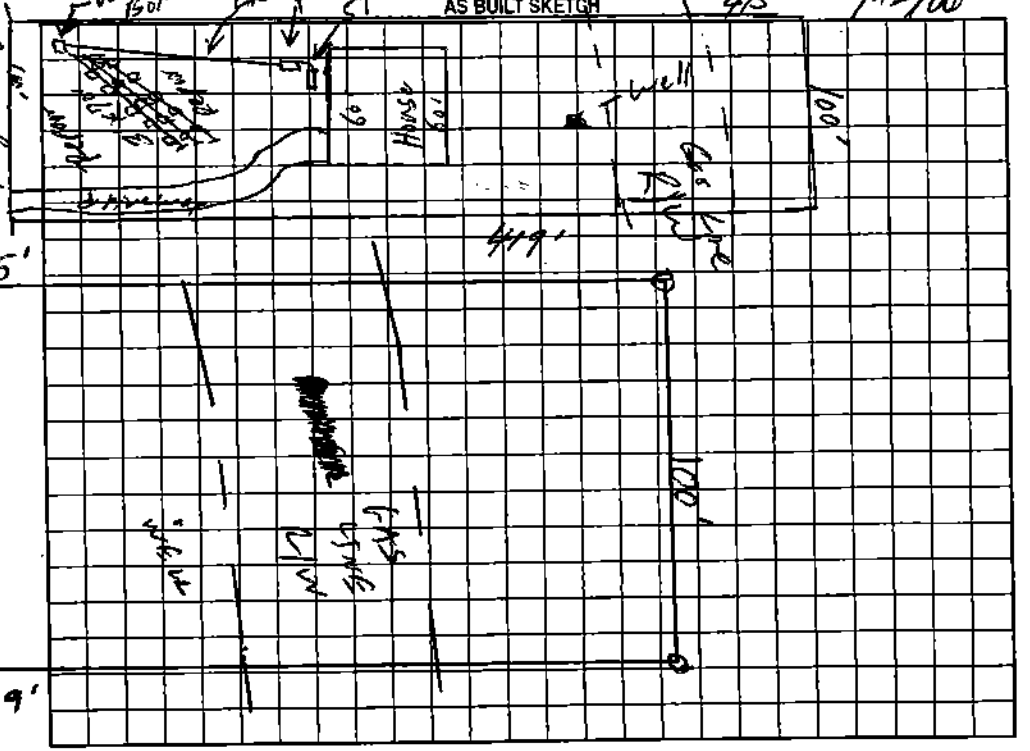

Permit can be suspended or revoked if any false information is supplied toward securing the permit/any unauthorized changes are made to the site/any unauthorized changes are made in the installation of the system. Improvement Permit with plat valid without expiration. Improvement Permit with site plan valid for sixty months. Authorization to Construct is valid for a period equal to that of Improvement Permit – not to exceed sixty months.

Signed: _____ date 10/8/02 Installed by: A-1 Backhoe (9/8/03)

Improvement Permit by: _____ RS date 7/27/01 Operation Permit by: William O. Johnson date 8/22/03

Authorization to Construct by: Patrick Mitchell date 10/09/02 Existing System Inspection by: _____ date _____

HEALTH DEPT COPY: WHITE OWNER COPY (FINAL): YELLOW OWNER COPY (INITIAL): PINK