IREDELL COUNTY HEALTH DEPARTMENT

STATESVILLE 704-878-5305 MOORESVILLE 704-664-5281

IMPROVEMENT PERMIT / AUTHORIZATION TO CONSTRUCT / OPERATION PERMIT / EXISTING SYSTEM INSPECTION

PERMIT# 100672 PIN# ~~4741 18 81X5 RF~~ 4741-77-8560 DATE 7/27/01

OWNER OR CONTRACTOR WILLIAM BRENSTER PHONE: Business 895-0556 Home

ADDRESS PO Box 99 DAVIDSON NC 28036

LOCATION 21S - TL MURDOCK - TR HOOVER - TL MARTHAS VINEYARD - TR PAINTED BUNTING - ON RT

SUBDIVISION MARTHAS VINEYARD BLOCK / SECTION 2 LOT 29 LOT AREA .954C SITE CLASS. PS DESIGN FLOW 360GPD L.T.A.R. .3600/FT²

Septic Tank: 1000 Gallons: STB 1012 Date 3-29-02
Pump Tank: 1000 Gallons: PT 17 Date 4-21-03
Pump Make: Gould Model WE 0311M Serial No. G036169
Nitrification Field: No Fields 1 Square Feet 900 Linear Feet 300
No Lines 4@75' Trench Width 36" Max Trench Bottom Depth 36" Gravel Depth N/A

☑ New System ☐ Repair System Type: I, II, III, IV, V, VI
System Description: pump 25% REDUCTION
Repair System Description: LP PANEL
Maintenance Agreement Required: ☐ Yes ☑ No

☐ House/Mod. Home No. Bedrooms 3
☐ Mobile Home No. Bathrooms 3
☐ Business No. Employees
☐ Other


☐ Slab ☑ Crawl Space ☐ Basement w/plumbing ☐ Basement wo/plumbing

Water Supply: ☑ Individual ☐ Public ☐ Community


Comments/Conditions: 1) BACKFILL AGAINST HOUSE - DO NOT CUT OUT FOR POSITIVE DRAINAGE.

Comments/Conditions: - Tuff-Tite filter & ST marker Installed 10/24/03
- Infiltrator Chambers Installed - 48
5 lines @ 60 ft/ln - liner, okay 11/18/03
- Pressure check okay 10/29/03, Electrical + Alarm okay

INITIAL SITE SKETCH 1" = 50'

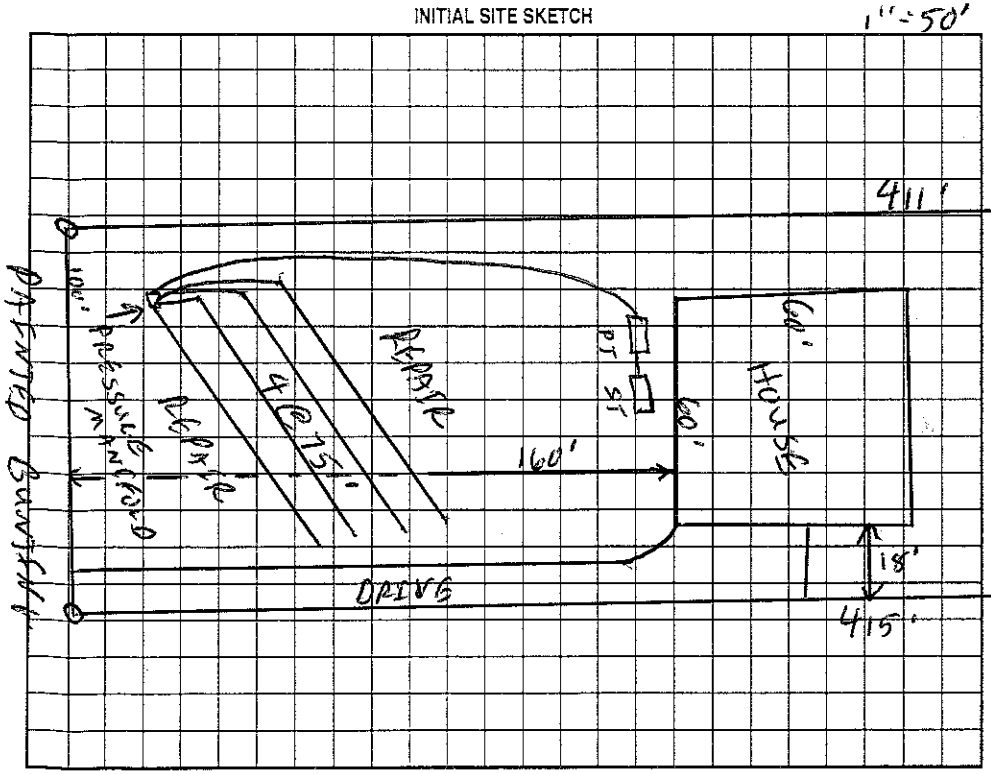

AS BUILT SKETCH

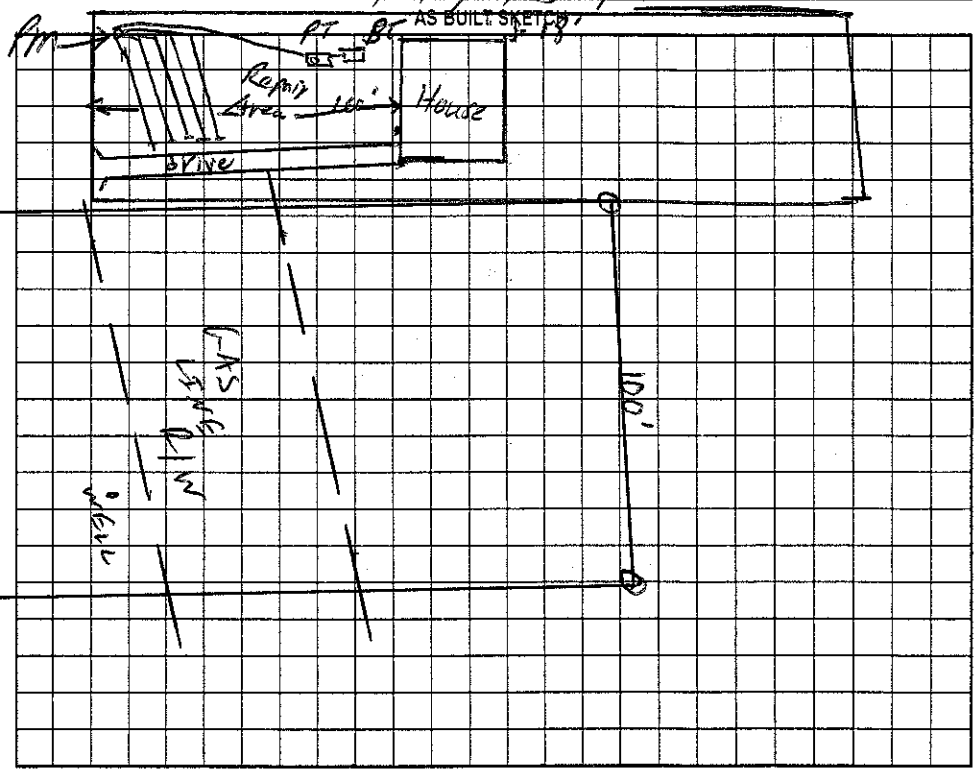

Permit can be suspended or revoked if any false information is supplied toward securing the permit/any unauthorized changes are made to the site/any unauthorized changes are made in the installation of the system. Improvement Permit with plat valid without expiration. Improvement Permit with site plan valid for sixty months. Authorization to Construct is valid for a period equal to that of Improvement Permit – not to exceed sixty months.

Signed: [signature] date 10/18/01 Installed by: A-1 Backhoe 10/29/03

Improvement Permit by: [signature] date 7/27/01 Operation Permit by: William Johnson date 11/18/03

Authorization to Construct by: Patrick Mitchell date 07/25/03 Existing System Inspection by: date

HEALTH DEPT. COPY: WHITE OWNER COPY (FINAL): YELLOW OWNER COPY (INITIAL): PINK