IREDELL COUNTY HEALTH DEPARTMENT

THIS PERMIT REPLACES PREVIOUS ISSUED 7-26-01

STATESVILLE 704-878-5305 (A) MOORESVILLE 704-664-5281

IMPROVEMENT PERMIT / AUTHORIZATION TO CONSTRUCT / OPERATION PERMIT / EXISTING SYSTEM INSPECTION

PERMIT# 100659 / 122036 PIN# 4741-77-9383 DATE 5-22-04

OWNER OR CONTRACTOR WILLIAM BREWSTER PHONE: Business 704-895-0556 Home 704-400-5066 (Donald Johnson)

ADDRESS P.O. BOX 99 DAVIDSON NC 28036

LOCATION US 21 S, TL MURDOCK RD, TR HOOVER RD, TL MARINA'S VINEYARD, TR PAINTED BUNTING, NEAR END ON RIGHT

SUBDIVISION MARINA'S VINEYARD BLOCK / SECTION ____ LOT 27 LOT AREA 0.747 ACRES SITE CLASS PS DESIGN FLOW 360' L.T.A.R. 0.30 GPD/FT²

Septic Tank: 1000 Gallons; STB 1012 Date 5-1-04

Pump Tank: 1000 Gallons; PT 17 Date 7-12-04

Pump Make: GOULDS Model WE0311M Serial No. H0477686

Nitrification Field: No Fields 1 Square Feet EW @ 1200 Linear Feet 200

No Lines TWO Trench Width 24" Max Trench Bottom Depth 36" Gravel Depth SAND 24"

☑ New System ☐ Repair System Type: I, II, III, (IV), V, VI

System Description: 50% REDUCTION, LOW PRESSURE

Repair System Description: 50% REDUCTION, LOW-PRESSURE

Maintenance Agreement Required: ☐ Yes ☑ No

☑ House/Mod. Home ☐ Mobile Home ☐ Business ☐ Other


No. Bedrooms 3 No. Bathrooms 2.5 No. Employees ____

☐ Slab ☑ Crawl Space ☐ Basement w/plumbing ☐ Basement wo/plumbing


Water Supply: ☑ Individual ☐ Public ☐ Community WELL

Comments/Conditions: ① INSTALL 50% REDUCTION SYSTEM USING 4-6 PPBPS PANELS WITH LOW PRESSURE DISTRIBUTION ② SEE ATTACHED SHEETS FOR PUMP & LOW PRESSURE REQUIREMENTS, ③ A CONTRACT SHALL BE EXECUTED BETWEEN SYSTEM OWNER AND A MANAGEMENT ENTITY PRIOR TO ISSUANCE OF OPERATION PERMIT ④ THIS PERMIT IS FOR THREE BEDROOMS ONLY

INITIAL SITE SKETCH

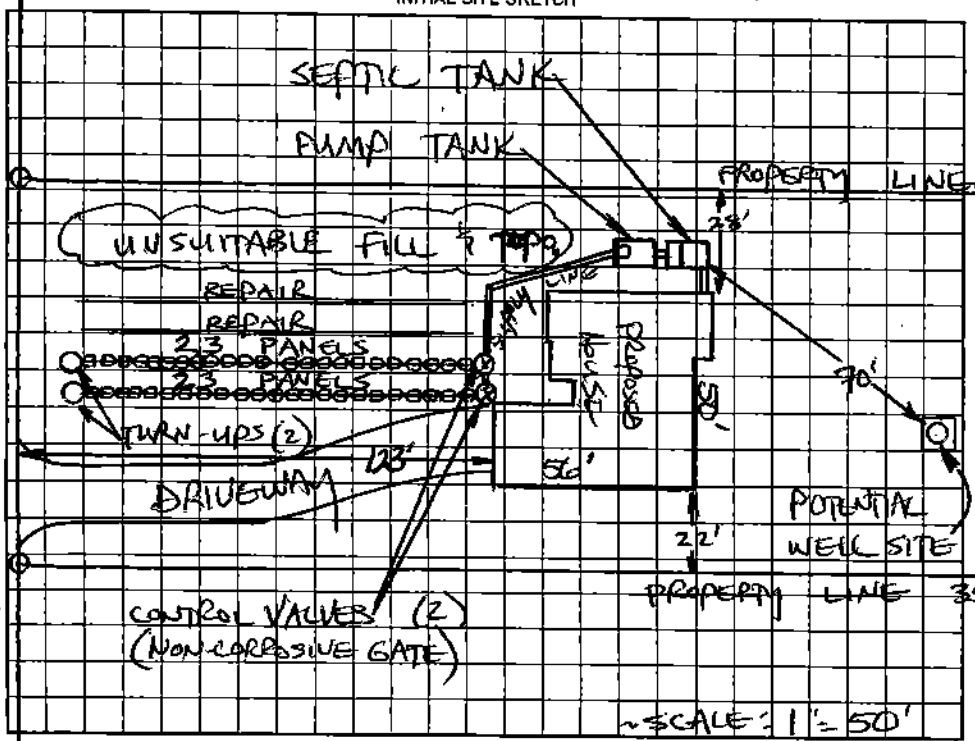

AS BUILT SKETCH

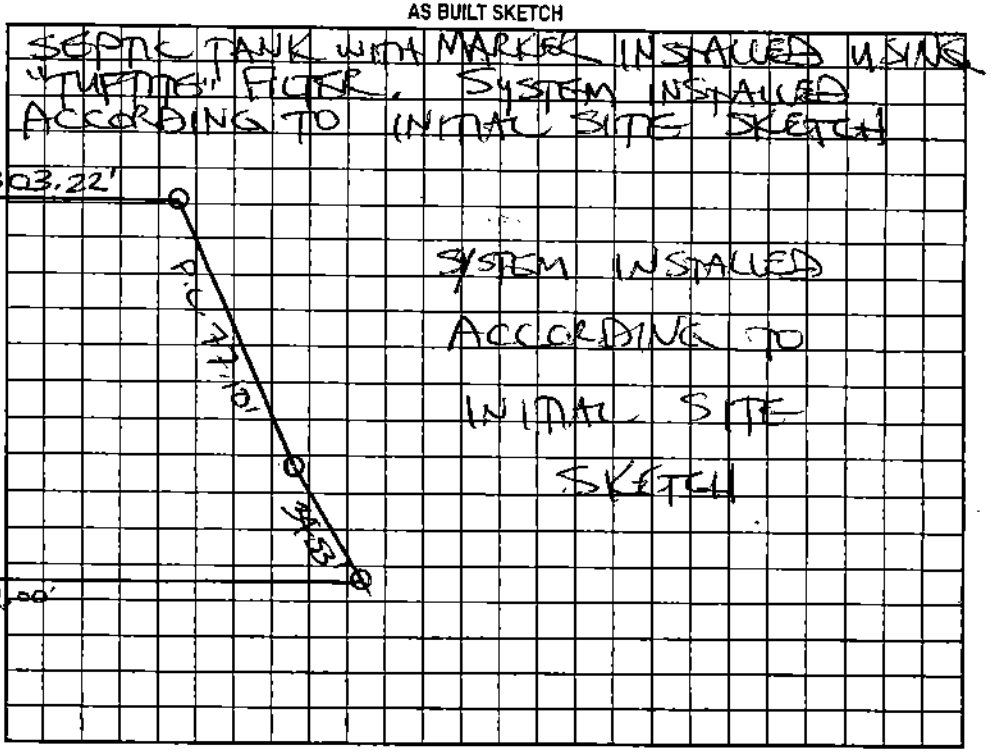

Permit can be suspended or revoked if any false information is supplied toward securing the permit/any unauthorized changes are made to the site/any unauthorized changes are made in the installation of the system. Improvement Permit with plan valid without expiration. Improvement Permit with site plan valid for sixty months. Authorization to Construct is valid for a period equal to that of Improvement Permit – not to exceed sixty months.

Signed: _____ date 6-9-04 Installed by: A-1 BACKHOE

Improvement Permit by: STEVE HEDRICK date 5-22-04 Operation Permit by: STEVE HEDRICK date 10-22-04

Authorization to Construct by: STEVE HEDRICK date 5-22-04 Existing System Inspection by: _____ date _____

HEALTH DEPT. COPY: WHITE OWNER COPY (FINAL): YELLOW OWNER COPY (INITIAL): PINK