*THIS PERMIT REPLACES VOID PERMIT ISSUED ON 07/30/02

IREDELL COUNTY HEALTH DEPARTMENT

STATESVILLE 704-878-5305 REVOKED MOORESVILLE 704-664-5281

IMPROVEMENT PERMIT / AUTHORIZATION TO CONSTRUCT / OPERATION PERMIT / EXISTING SYSTEM INSPECTION

PERMIT# 100550 PIN# ~~4741-78-8148 PT~~ 4741-78-1759 DATE 12/27/02

OWNER OR CONTRACTOR WILLIAM BREWSTER PHONE: Business 704-895-0556 ~~Home~~ BILL BONDURANT 704-664-7166

ADDRESS P.O. BOX 99 DAVIDSON, NC 28036

LOCATION MURDOCK RD. (L) HOOVER RD., (L) MARTHA'S VINEYARD, 1ST LOT ON LEFT, ON CORNER.

SUBDIVISION MARTHA'S VINEYARD BLOCK / SECTION 2 LOT 1 LOT AREA 1.06 ACRES SITE CLASS. PS DESIGN FLOW 480 GPD L.T.A.R. 0.30 GPD/FT²

Septic Tank: 1,000 Gallons; STB 825 Date 10/08/02
Pump Tank: 1,000 Gallons; PT 302 Date 13/04/02
Pump Make: ZOELLER Model N-137-C Serial No. ½ H.P.
Nitrification Field: No Fields 1 Square Feet EQ to 1,600 Linear Feet 400
No Lines 4@100' Trench Width 36" Max Trench Bottom Depth 36" Gravel Depth N/A

[X] New System [ ] Repair System Type: I, II, (III), IV, V, VI
System Description: PUMP, 25% REDUCTION
Repair System Description: LOW PRESSURE, 50% Reduc.
Maintenance Agreement Required: [ ] Yes [X] No

[X] House/Mod. Home No. Bedrooms 4
[ ] Mobile Home No. Bathrooms 3
[ ] Business No. Employees
[ ] Other
[X] Slab [ ] Crawl Space [ ] Basement w/plumbing [ ] Basement wo/plumbing


Water Supply: [X] Individual [ ] Public [ ] Community WELL

Comments/Conditions: (1) KEEP WELL 100' PLUS FROM SYSTEM (2) SEE ATTACHED SHEETS FOR PUMP & PRESSURE MANIFOLD INFO.


Comments/Conditions: *SEPTIC TANK INSTALLED USING TANK MARKER & POLY-LOC FILTER.

SYSTEM INSTALLED DURING PERIOD OF MOIST SOIL CONDITIONS.

INITIAL SITE SKETCH

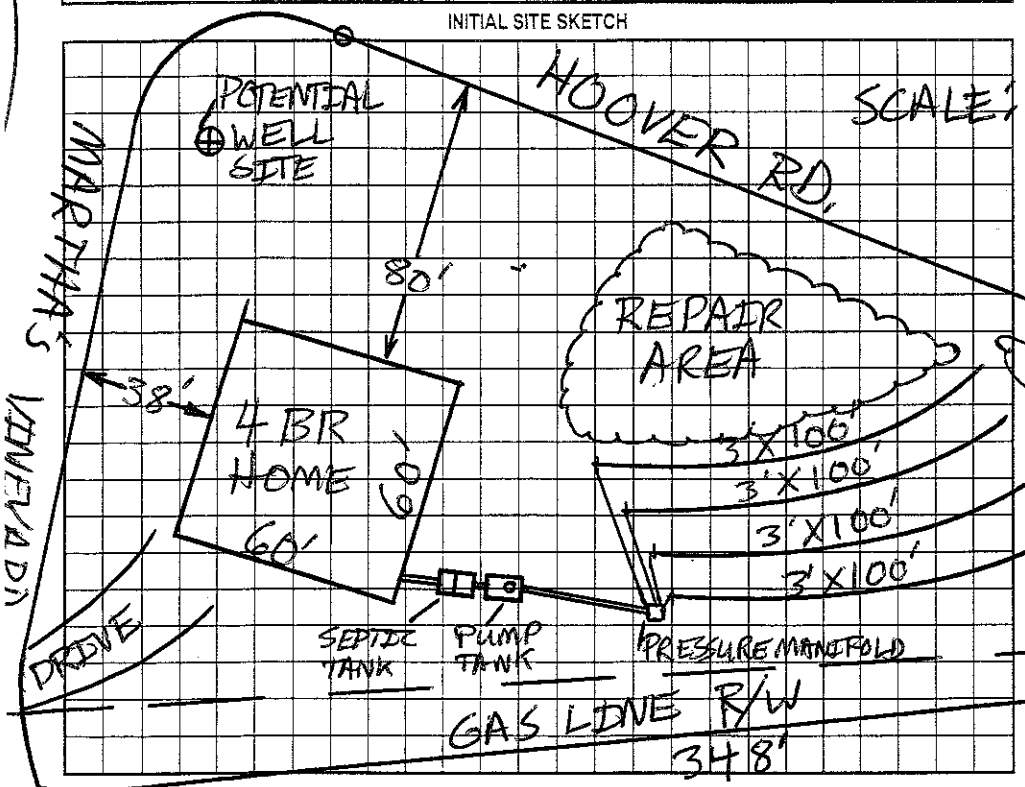

AS BUILT SKETCH

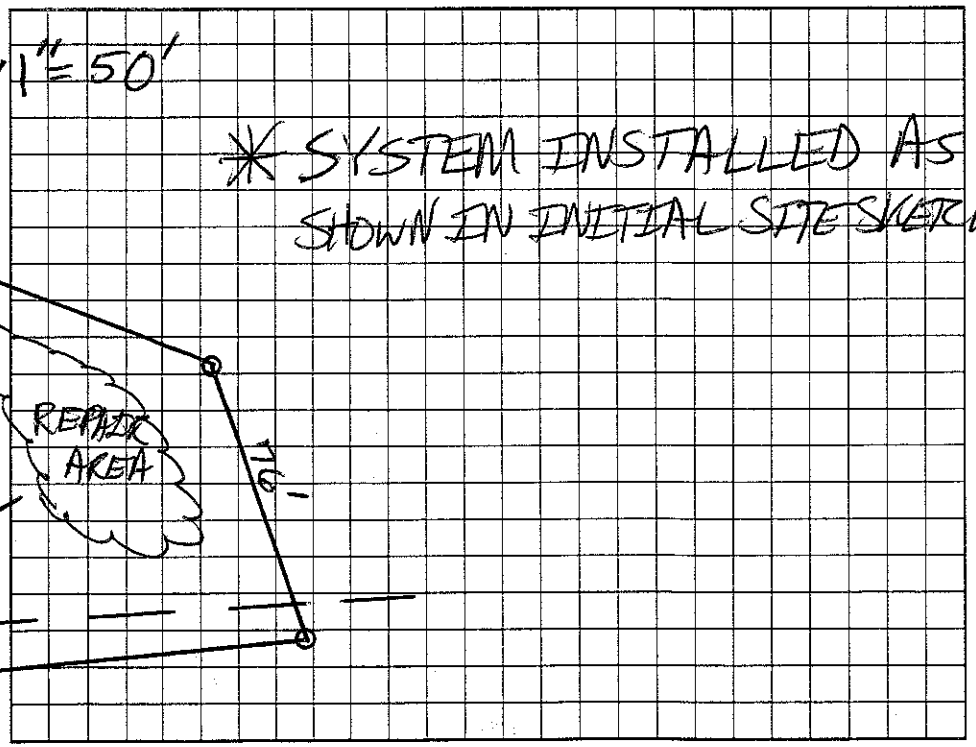

Permit can be suspended or revoked if any false information is supplied toward securing the permit/any unauthorized changes are made to the site/any unauthorized changes are made in the installation of the system. Improvement Permit with plat valid without expiration. Improvement Permit with site plan valid for sixty months. Authorization to Construct is valid for a period equal to that of Improvement Permit – not to exceed sixty months.

Signed: [signature] date 12/30/02 Installed by: JOE THOMPSON 01/15/03

Improvement Permit by: [signature] date 12/27/02 Operation Permit by: Patrick Mitchell date 03/07/03

Authorization to Construct by: [signature] date 12/30/02 Existing System Inspection by: _____ date _____

HEALTH DEPT. COPY: WHITE OWNER COPY (FINAL): YELLOW OWNER COPY (INITIAL): PINK