This permit voids previously issued permit dated 7/25/03

IREDELL COUNTY HEALTH DEPARTMENT

STATESVILLE 704-878-5305 MOORESVILLE 704-664-5281

IMPROVEMENT PERMIT / AUTHORIZATION TO CONSTRUCT / OPERATION PERMIT / EXISTING SYSTEM INSPECTION

PERMIT# 100687 PIN# 4741-78-~~8468~~ 3123 ~~9446~~ DATE 10/24/03

OWNER OR CONTRACTOR William Drew Stey PHONE: Business (704) 895-0556 ~~Home~~ (704) 664-7166

ADDRESS P.O. Box 99 Davidson NC 28036

LOCATION Hwy 21 South (L) Murdock Rd (R) Hoover Rd, 3rd lot on left past Marthas Vineyard Rd

SUBDIVISION Marthas Vineyard BLOCK / SECTION 1 LOT 44 LOT AREA 0.91 Acres SITE CLASS. 15 DESIGN FLOW 480 L.T.A.R. 0.275 gpd/ft²

Septic Tank: 1,060 Gallons; STB 1012 Date 4-20-03
Pump Tank: 1000 Gallons; PT 17 Date 4-602
Pump Make: Gould's Model WE0311M Serial No. JA353749
Nitrification Field: No Fields 1 Square Feet 2 @ 1176 Linear Feet 450
No Lines 5 @ 90' Trench Width 36" Max Trench Bottom Depth 36" Gravel Depth N/A

☒ New System ☐ Repair System Type: I, II, (III), IV, V, VI
System Description: Pump, 25% Reduction
Repair System Description: Pump, 50% Reduction-LPP
Maintenance Agreement Required: ☐ Yes ☒ No


☒ House/Mod. Home ☐ Mobile Home ☐ Business ☐ Other
No. Bedrooms 4 No. Bathrooms 3 No. Employees ___
☐ Slab ☒ Crawl Space ☐ Basement w/plumbing ☐ Basement wo/plumbing

Water Supply: ☒ Individual ☐ Public ☐ Community
Well


Comments:/Conditions: (1) Install 25% Reduction System on contour
(2) Maintain Proper Setbacks

Comments:/Conditions: -Tuff-Tite Filter & ST Marker Installed - 10/24/03
-75 Infiltrator Chambers Installed, Liner okay 10/28/03
-Pressure check okay 10/29/03 WP
-Electrical & Alarm Okay - 1/21/04

INITIAL SITE SKETCH

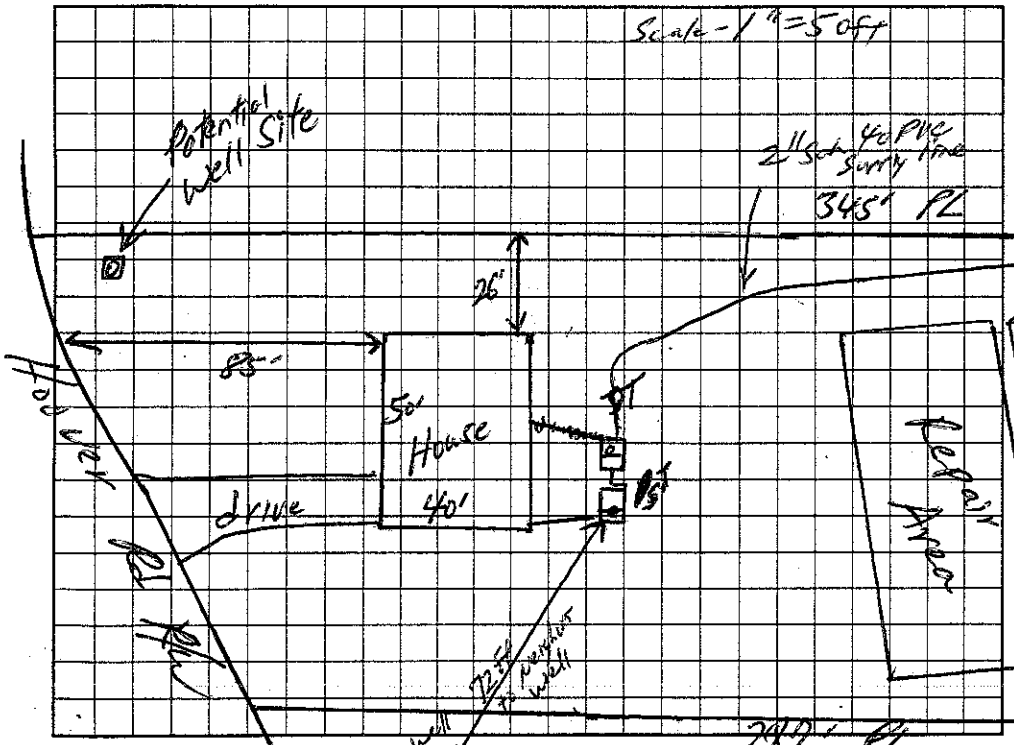

AS BUILT SKETCH

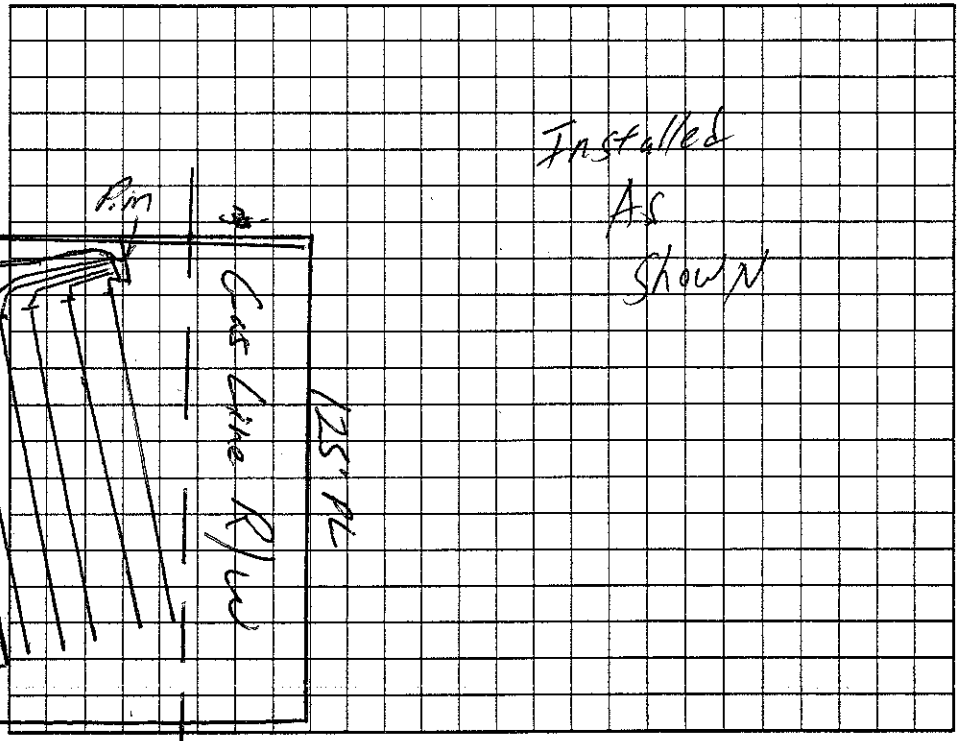

Permit can be suspended or revoked if any false information is supplied toward securing the permit/any unauthorized changes are made to the site/any unauthorized changes are made in the installation of the system. Improvement Permit with plat valid without expiration. Improvement Permit with site plan valid for sixty months. Authorization to Construct is valid for a period equal to that of Improvement Permit – not to exceed sixty months.

Signed: X _____ date 10/29/03 Installed by: A-1 Backhoe 10/28/03

Improvement Permit by: William O. Johnson date 10/29/03 Operation Permit by: William O. Johnson date 1/21/04

Authorization to Construct by: William O. Johnson date 10/29/03 Existing System Inspection by: _____ date _____

HEALTH DEPT. COPY: WHITE OWNER COPY (FINAL): YELLOW OWNER COPY (INITIAL): PINK