*THIS PERMIT VOIDS PREVIOUS PERMIT, ISSUED ON 07/20/01.

IREDELL COUNTY HEALTH DEPARTMENT

STATESVILLE 704-878-5305 MOORESVILLE 704-664-5281

IMPROVEMENT PERMIT / AUTHORIZATION TO CONSTRUCT / OPERATION PERMIT / EXISTING SYSTEM INSPECTION

PERMIT# 100552 PIN# ~~4741-78-8148 (PT)~~ 4741-78-3889 DATE 05/28/03

OWNER OR CONTRACTOR WILLIAM BREWSTER Co. PHONE: Business 704-895-0556 ~~Home~~ 704-664-7166 704-400-5066

ADDRESS P.O. BOX 99 DAVIDSON, NC 28036

LOCATION 21 SOUTH, (L) MURDOCH, (R) HOOVER, (L) MARTHAS VINEYARD, (L) PAINTED BUNTING, ON LEFT JUST BEFORE CUL-DE-SAC.

SUBDIVISION MARTHAS VINEYARD BLOCK / SECTION 2 LOT 3 LOT AREA 0.76 ACRES SITE CLASS. PS DESIGN FLOW 480 GPD L.T.A.R. 0.30 GPD/FT²

Septic Tank: 1,000 Gallons; STB 1012 Date 01/13/03
Pump Tank: ____ Gallons; PT ____ Date ____
Pump Make: ____ Model ____ Serial No. ____
Nitrification Field: No Fields 1 Square Feet EQ to 1,600 Linear Feet 270
No Lines 6 @ 45' Trench Width 24" Max Trench Bottom Depth 36" Gravel Depth N/A

[X] New System [ ] Repair System Type: I, II, (III), IV, V, VI
System Description: 50% REDUCTION, GRAVITY
Repair System Description: SAME
Maintenance Agreement Required: [ ] Yes [X] No


[X] House/Mod. Home No. Bedrooms 4
[ ] Mobile Home No. Bathrooms 2½
[ ] Business No. Employees ____
[ ] Other ____
[X] Slab [ ] Crawl Space [ ] Basement w/plumbing [ ] Basement wo/plumbing

Water Supply: [X] Individual [ ] Public [ ] Community: WELL


Comments/Conditions: (1) INSTALL SYSTEM USING 10 PANELS PER LINE (60 PANELS TOTAL TO EQUAL 270'). (2) USE 1 FLOW DIVIDER "T" + 2 DISTRIBUTION BOXES WITH SPEED LEVELERS TO ACHIEVE EQUAL DISTRIBUTION.

Comments/Conditions: *TUFF-TIGHT FILTER USED IN S.T.

INITIAL SITE SKETCH

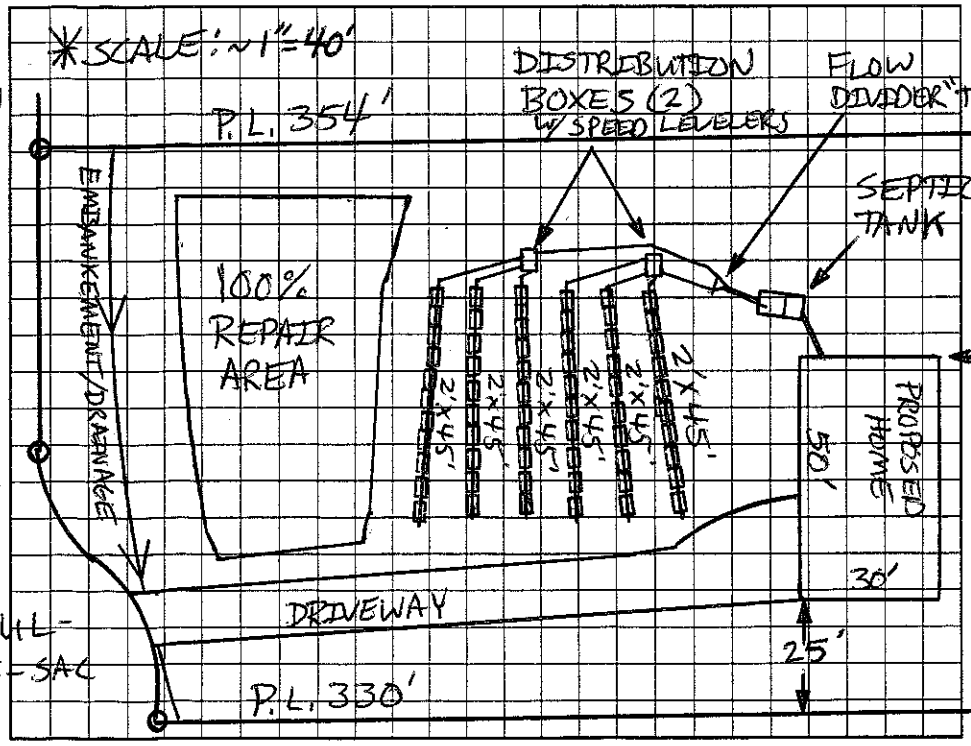

AS BUILT SKETCH

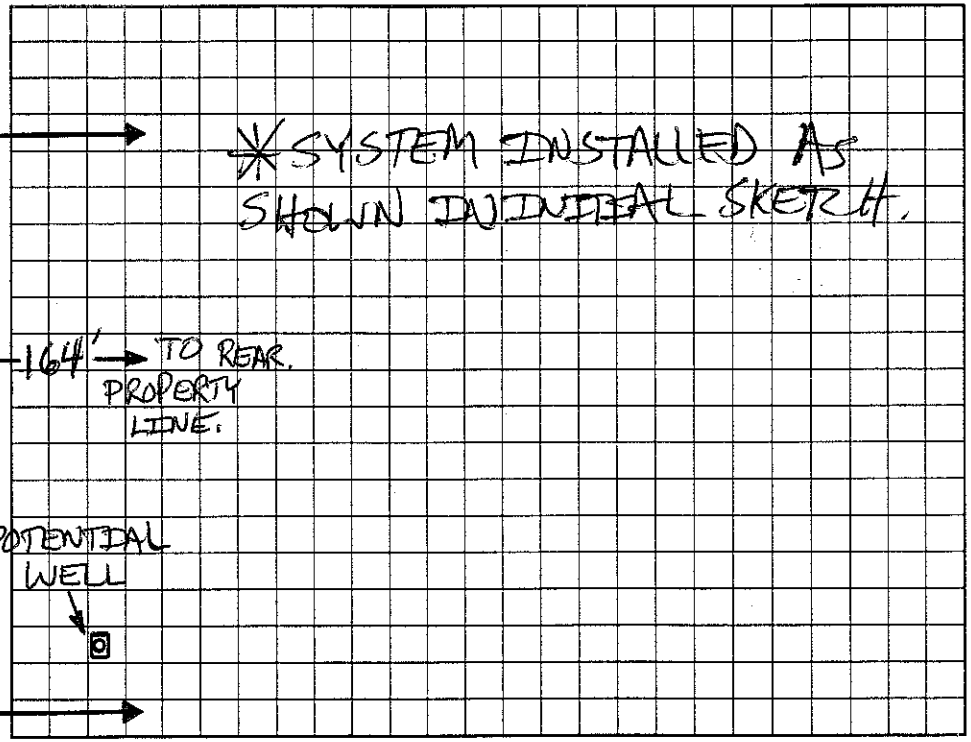

Permit can be suspended or revoked if any false information is supplied toward securing the permit/any unauthorized changes are made to the site/any unauthorized changes are made in the installation of the system. Improvement Permit with plat valid without expiration. Improvement Permit with site plan valid for sixty months. Authorization to Construct is valid for a period equal to that of Improvement Permit – not to exceed sixty months.

Signed: Angie Blount date 5/20/03 Installed by: A-1 BACKHOE

Improvement Permit by: Patrick Mitchell date 05/28/03 Operation Permit by: Patrick Mitchell date 08/07/03

Authorization to Construct by: Patrick Mitchell date 05/28/03 Existing System Inspection by: ____ date ____

HEALTH DEPT. COPY: WHITE OWNER COPY (FINAL): YELLOW OWNER COPY (INITIAL): PINK