IREDELL COUNTY HEALTH DEPARTMENT

STATESVILLE 704-878-5305 MOORESVILLE 704-664-5281

IMPROVEMENT PERMIT / AUTHORIZATION TO CONSTRUCT / OPERATION PERMIT / EXISTING SYSTEM INSPECTION

PERMIT# 100684 PIN# 4741 78 8148 PT DATE 7/30/01

OWNER OR CONTRACTOR WILLIAM BREWSTER PHONE: Business 895-0556 Home

ADDRESS PO Box 99 DAVIDSON NC 28036

LOCATION 215 - TL MURDOCK - TR HOOVER - TL MARTHAS VINEYARD - ON RT CORNER OF PAINTED BUNTING

SUBDIVISION MARTHAS VINEYARD BLOCK / SECTION LOT 41 LOT AREA .87 AC SITE CLASS PS DESIGN FLOW 360GPD L.T.A.R. 360GPD/FT

Septic Tank: 1000 Gallons. STB 825 Date 05/15/02
Pump Tank: Gallons. PT Date
Pump Make: Model Serial No
Nitrification Field: No. Fields 1 Square Feet 1206 Linear Feet 402
No. Lines 6 Trench Width 36" Max Trench Bottom Depth 36" Gravel Depth 12"

☑ New System ☐ Repair System Type: ☐ I ☐ II ☐ III ☑ IV ☐ V ☐ VI
System Description: GRAVITY CONVENTIONAL
Repair System Description: INNOVATIVE/GRAVITY
Maintenance Agreement Required: ☐ Yes ☑ No
☐ Slab ☑ Crawl Space ☐ Basement w/plumbing ☐ Basement wo/plumbing


☑ House/Mod. Home No. Bedrooms 3
☐ Mobile Home No. Bathrooms 3
☐ Business No. Employees
☐ Other

Water Supply: ☐ Individual ☐ Public ☐ Community


Comments/Conditions: ② HOME WAS MOVED CLOSER TO FRONT WITH OUT PRIOR HEALTH DEPARTMENT APPROVAL (76' FROM FRONT OF HOME TO ROAD) RESULTING IN SYSTEM TO BE CHANGED ALSO WITH OUT PRIOR APPROVAL. SYSTEM IS SHOWN IN AS BUILT SKETCH

Comments/Conditions: ① SEPTIC TANK INSTALLED WITH POLY-LOCK FILTER & SEPTIC TANK MARKER

INITIAL SITE SKETCH 1"=50'

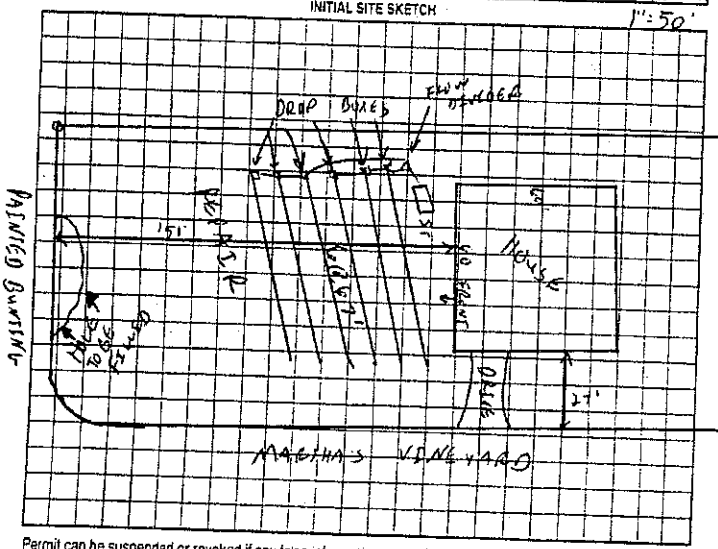

AS BUILT SKETCH

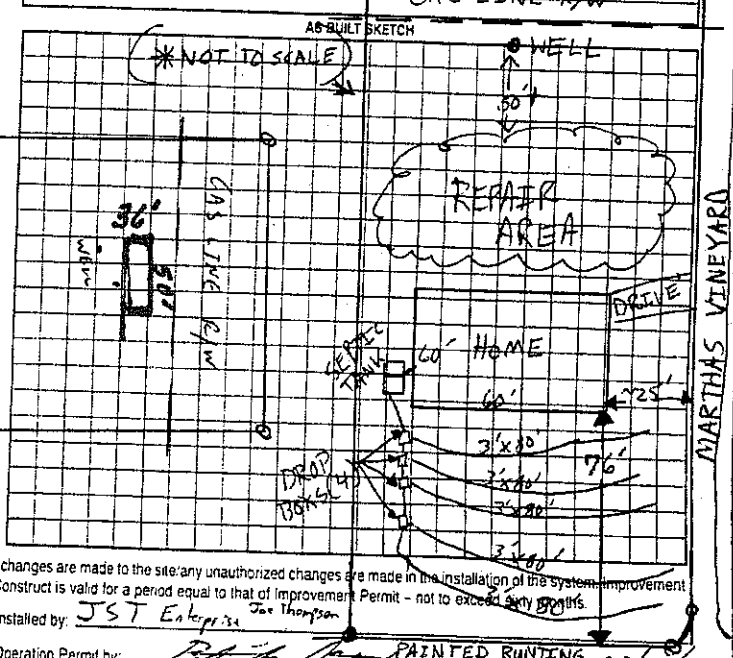

Permit can be suspended or revoked if any false information is supplied toward securing the permit/any unauthorized changes are made to the site/any unauthorized changes are made in the installation of the system. Improvement Permit with plat valid without expiration. Improvement Permit with site plan valid for sixty months. Authorization to Construct is valid for a period equal to that of Improvement Permit – not to exceed sixty months.

Signed: date 8/8/01

Improvement Permit by: date 7/30/01

Authorization to Construct by: date 11/14/02

Installed by: JST Enterprises Joe Thompson

Operation Permit by: date 08/08/02

Existing System Inspection by: date

HEALTH DEPT. COPY WHITE OWNER COPY (FINAL) YELLOW OWNER COPY (INITIAL) PINK

The location of the proposed detached garage addition does not appear to impact the existing septic system. **NOTE:

REHS

Date: 4-13-11

ICHD-Environmental Health Division