IREDELL COUNTY HEALTH DEPARTMENT

THIS PERMIT VOIDS PREVIOUS ISSUED 7/20/01

STATESVILLE 704-878-5305 MOORESVILLE 704-664-5281

IMPROVEMENT PERMIT / AUTHORIZATION TO CONSTRUCT / OPERATION PERMIT / EXISTING SYSTEM INSPECTION

PERMIT# 100551 PIN# 4741-78-4728 DATE 11-20-03

OWNER OR CONTRACTOR WILLIAM BREWSTER COMPANY PHONE: Business 704-895-0556 Home 704-400-5066

ADDRESS P.O. Box 99 DAVIDSON NC 28036

LOCATION US 21 SOUTH TL MURDOCK RD TR HOOVER RD TL MARTHA'S VINEYARD DRIVE, 2ND LOT ON LEFT

SUBDIVISION MARTHA'S VINEYARD BLOCK / SECTION 2 LOT 2 LOT AREA 0.90 ACRES SITE CLASS. PS DESIGN FLOW 480 L.T.A.R. 0.30 GPD/FT²

Septic Tank: 1000 Gallons; STB 102 Date 8-5-03
Pump Tank: ____ Gallons; PT ____ Date ____
Pump Make: ____ Model ____ Serial No. ____
Nitrification Field: No Fields 1 Square Feet REQ'D 1600 Linear Feet 400
No Lines SIX Trench Width 36" Max Trench Bottom Depth 36" Gravel Depth N/A

☑ New System ☐ Repair System Type: I, II, III, IV, V, VI
System Description: 25% REDUCTION, GRAVITY
Repair System Description: 50% REDUCTION LOW PRESSURE
Maintenance Agreement Required: ☐ Yes ☑ No ☐ Other ____


☑ House/Mod. Home No. Bedrooms 4
☐ Mobile Home No. Bathrooms 3
☐ Business No. Employees ____
☑ Slab ☐ Crawl Space ☐ Basement w/plumbing ☐ Basement wo/plumbing

Water Supply: ☑ Individual ☐ Public ☐ Community WELL


Comments:/Conditions: ① INSTALL 25% REDUCTION SYSTEM AS SHOWN IN SIX EQUAL LENGTH LINES, MINIMUM 10' FROM PROPERTY LINE & 15' FROM TOP OF SLOPE OF EMBANKMENT; 100' FROM WELL. ② NO VEHICULAR TRAFFIC ALLOWED OVER SYSTEM.

Comments:/Conditions: 1/2 HP SUBMERSIBLE PUMP WITH FLOAT & FILTER MARKER WELL NOT INSTALLED AT TIME OF CHECK INSTALLED AS DRAWN

INITIAL SITE SKETCH

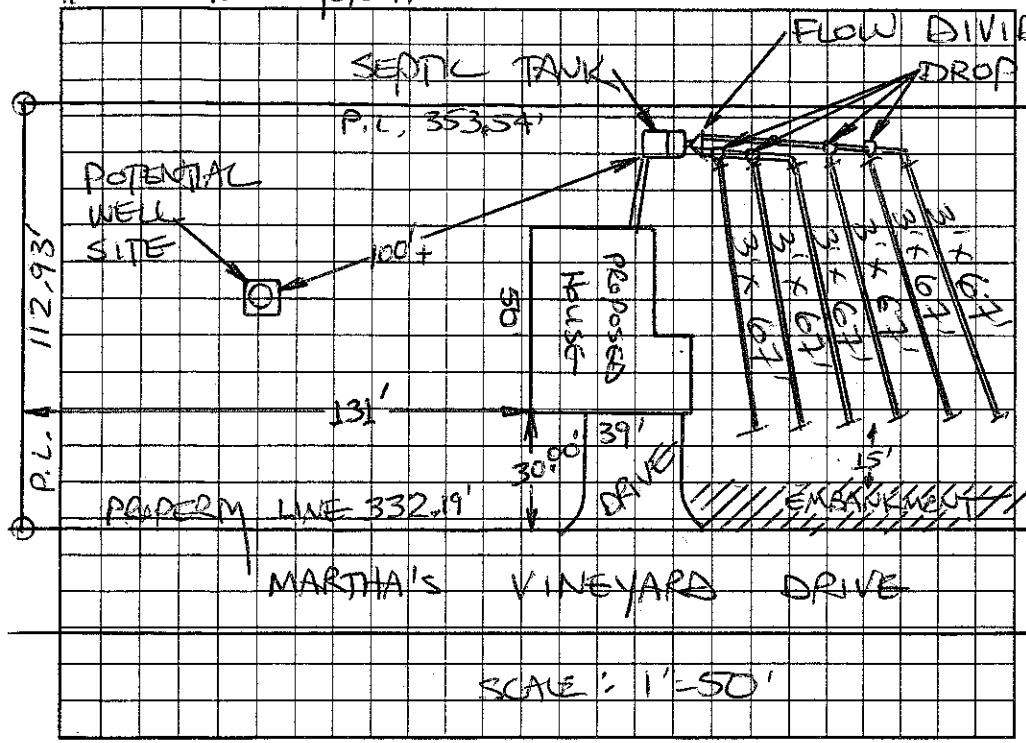

AS BUILT SKETCH

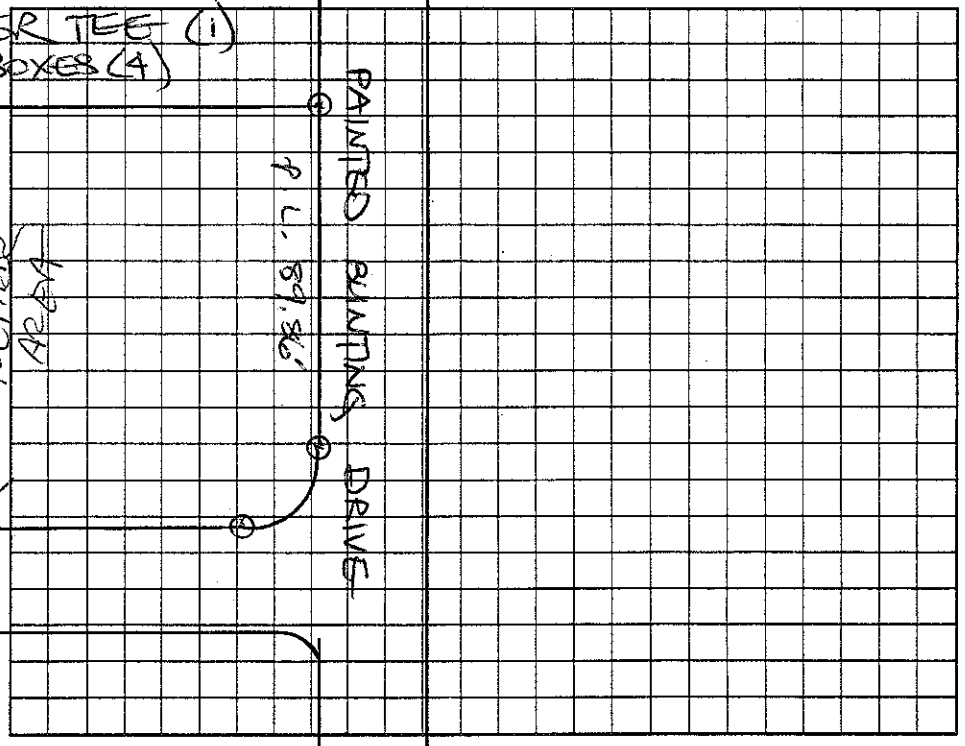

Permit can be suspended or revoked if any false information is supplied toward securing the permit/any unauthorized changes are made to the site/any unauthorized changes are made in the installation of the system. Improvement Permit with plat valid without expiration. Improvement Permit with site plan valid for sixty months. Authorization to Construct is valid for a period equal to that of Improvement Permit – not to exceed sixty months.

Signed: Angie Brown date 11/21/03 Installed by: A-1 BACKHOE

Improvement Permit by: STEVE HEDRICK date 11-20-03 Operation Permit by: [signature] date 1-15-04

Authorization to Construct by: STEVE HEDRICK date 11-20-03 Existing System Inspection by: ____ date ____

HEALTH DEPT. COPY: WHITE OWNER COPY (FINAL): YELLOW OWNER COPY (INITIAL): PINK