122035

IREDELL COUNTY HEALTH DEPARTMENT

THIS PERMIT REPLACES PREVIOUS ISSUED 7-30-01

STATESVILLE 704-878-5305 (1) MOORESVILLE 704-664-5281

IMPROVEMENT PERMIT / AUTHORIZATION TO CONSTRUCT / OPERATION PERMIT / EXISTING SYSTEM INSPECTION

PERMIT# 10068531220335 PIN# 4741-78-5514 DATE 5-22-04

OWNER OR CONTRACTOR WILLIAM BREWSTER PHONE: Business 704-895-0556 Home 704-400-5066 (Doug Johnson)

ADDRESS P.O. Box 99, DAVIDSON, NC 28036

LOCATION US 21S, TL MURDOCK RD, TL HOOVER RD, TL MARTHA'S VINEYARD, TR PAINTED BUNTING, 2ND LOT ON RIGHT

SUBDIVISION MARTHA'S VINEYARD BLOCK / SECTION 2 LOT 40 LOT AREA 0.801 ACRES SITE CLASS. PS DESIGN FLOW 480' L.T.A.R. 0.30 GPD/FT²

Septic Tank: 1000 Gallons; STB 1012 Date 5-7-04

Pump Tank: _____ Gallons; PT _____ Date _____

Pump Make: _____ Model _____ Serial No. _____

Nitrification Field: No Fields 1 Square Feet EQ. TO 1600 Linear Feet 400

No Lines SIX Trench Width 36" Max Trench Bottom Depth 36" Gravel Depth N/A

☑ New System ☐ Repair System Type: I, II, (III), IV, V, VI

System Description: 25% REDUCTION, GRAVITY

Repair System Description: LOW PRESSURE 50% REDUCTION

Maintenance Agreement Required: ☐ Yes ☑ No

☑ House/Mod. Home No. Bedrooms 4

☐ Mobile Home No. Bathrooms 2.5

☐ Business No. Employees ____

☐ Other _____


☐ Slab ☑ Crawl Space ☐ Basement w/plumbing ☐ Basement wo/plumbing

Water Supply: ☑ Individual ☐ Public ☐ Community WELL

Comments:/Conditions: INSTALL 25% REDUCTION SYSTEM IN SIX LINES AS SHOWN ON CONTOUR. USE ONE FLOW DIVIDER TEE TO ACHIEVE EQUAL DISTRIBUTION INTO EACH SUBFIELD.

Comments:/Conditions: SEPTIC TANK WITH MARKER INSTALLED USING "TUFTITE" FILTER

INITIAL SITE SKETCH

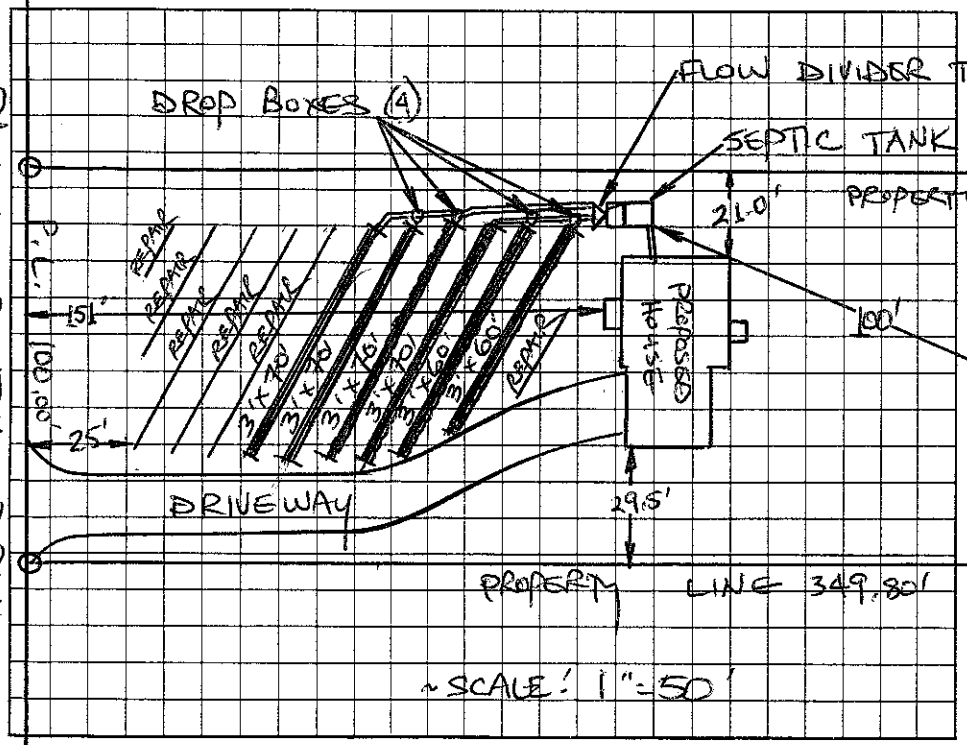

AS BUILT SKETCH

SYSTEM INSTALLED ACCORDING TO INITIAL SITE SKETCH

Permit can be suspended or revoked if any false information is supplied toward securing the permit/any unauthorized changes are made to the site/any unauthorized changes are made in the installation of the system. Improvement Permit with plat valid without expiration. Improvement Permit with site plan valid for sixty months. Authorization to Construct is valid for a period equal to that of Improvement Permit – not to exceed sixty months.

Signed: _____ date 6-9-04

Improvement Permit by: STEVE HEDRICK date 5-22-04

Authorization to Construct by: STEVE HEDRICK date 5-22-04

Installed by: A-1 BACKHOE

Operation Permit by: STEVE HEDRICK date 9-23-04

Existing System Inspection by: _____ date _____

HEALTH DEPT. COPY: WHITE OWNER COPY (FINAL): YELLOW OWNER COPY (INITIAL): PINK