IREDELL COUNTY HEALTH DEPARTMENT

STATESVILLE 704-878-5305 MOORESVILLE 704-664-5281

IMPROVEMENT PERMIT / AUTHORIZATION TO CONSTRUCT / OPERATION PERMIT / EXISTING SYSTEM INSPECTION

PERMIT# 100679 PIN# ~~4741-78-8148 PS~~ 4741-78-6166 DATE 7/27/01

OWNER OR CONTRACTOR WILLIAM BREWSTER PHONE: Business 895-0556 Home

ADDRESS PO BOX 99 DAVIDSON NC 28036

LOCATION 215-TL MURDOCK-TR HOOVER-TL MARTHAS VINEYARD-TR PAINTED BUNTING-ON RT

SUBDIVISION MARTHAS VINEYARD BLOCK / SECTION 2 LOT 36 LOT AREA .79 SITE CLASS. PS DESIGN FLOW 360 GPD L.T.A.R. .36 GPD/FT

Septic Tank: 1000 Gallons; STB 1012 Date 05/25/02

Pump Tank: ___ Gallons; PT ___ Date ___

Pump Make: ___ Model ___ Serial No. ___

Nitrification Field: No Fields 1 Square Feet 1200 Linear Feet ~~400~~ 400

No Lines ~~6 @ 67'~~ 7 Trench Width 36" Max Trench Bottom Depth 36"

☑ New System ☐ Repair System Type: I (II) III, IV, V, VI

System Description: GRAVITY CONVENTIONAL

Repair System Description: ~~SAME~~ 50% Reduction

Maintenance Agreement Required: ☐ Yes ☑ No

Gravel Depth 12"

☑ House/Mod. Home No. Bedrooms 3

☐ Mobile Home No. Bathrooms 3

☐ Business No. Employees ___

☐ Other ___

☐ Slab ☑ Crawl Space ☐ Basement w/plumbing ☐ Basement wo/plumbing


Water Supply: ☑ Individual ☐ Public ☐ Community

Comments:/Conditions:

Comments:/Conditions: SEPTIC TANK INSTALLED USING TUFF-TIGHT-FILTER & TANK MARKER.

*SYSTEM INSTALLED DURING WET SOIL CONDITIONS.


INITIAL SITE SKETCH 1" = 50'

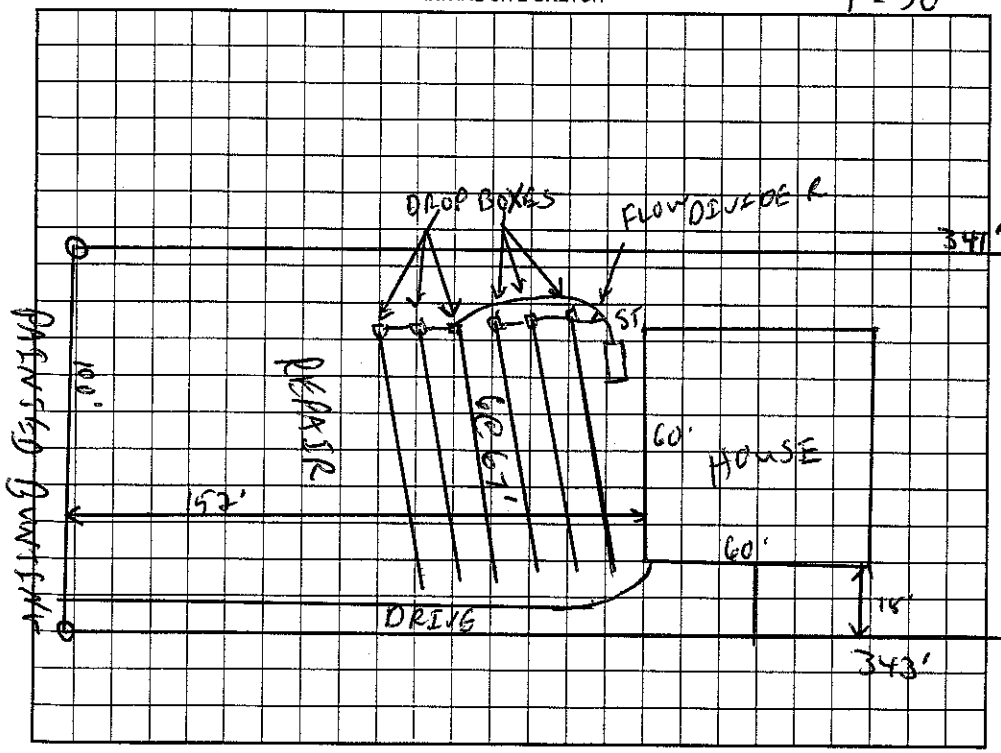

AS BUILT SKETCH

*DRIVE WAS CHANGED W/OUT APPROVAL.

*SYSTEM INSTALLED AS SHOWN AS BUILT SKETCH

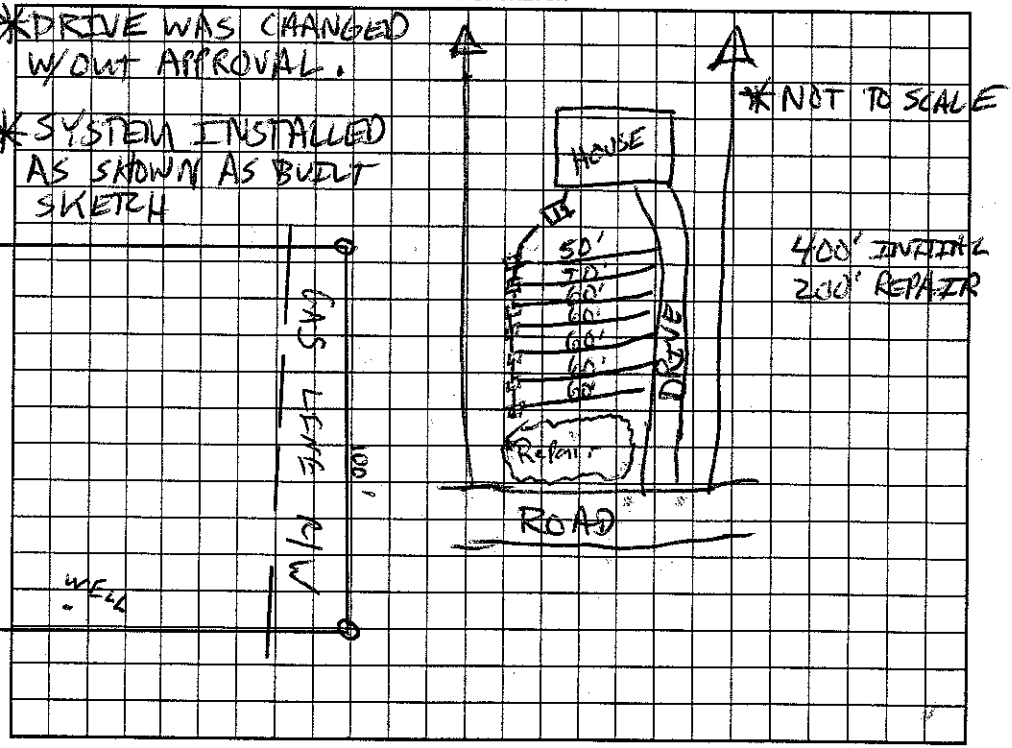

Permit can be suspended or revoked if any false information is supplied toward securing the permit/any unauthorized changes are made to the site/any unauthorized changes are made in the installation of the system. Improvement Permit with plat valid without expiration. Improvement Permit with site plan valid for sixty months. Authorization to Construct is valid for a period equal to that of Improvement Permit – not to exceed sixty months.

Signed: ___ date 10/8/01

Improvement Permit by: ___ date 7/27/01

Authorization to Construct by: Patrick Mitchell date 10/09/02

Installed by: A-1 BACKHOE 02-26-03

Operation Permit by: Patrick Mitchell date 02/26/03

Existing System Inspection by: ___ date ___

HEALTH DEPT. COPY: WHITE OWNER COPY (FINAL): YELLOW OWNER COPY (INITIAL): PINK