IREDELL COUNTY HEALTH DEPARTMENT

STATESVILLE 704-878-5305 MOORESVILLE 704-664-5281

IMPROVEMENT PERMIT / AUTHORIZATION TO CONSTRUCT / OPERATION PERMIT / EXISTING SYSTEM INSPECTION

PERMIT# 100680 PIN# ~~4741-78-8148-PT~~ 4741-78-6225 DATE 7/27/01

OWNER OR CONTRACTOR WILLIAM BREWSTER PHONE: Business 895-0556 Home

ADDRESS PO BOX 99 DAVIDSON - NC 28036

LOCATION 21S - TL MURDOCK - TR HOOVER - TL MARTHAS VINEYARD - TR PAINTED BUNTING - ON RT

SUBDIVISION MARTHAS VINEYARD BLOCK / SECTION II LOT 37 LOT AREA .79AC SITE CLASS. PS DESIGN FLOW 360GD L.T.A.R. 36-10/FT

Septic Tank: 1000 Gallons; STB 1012 Date 5-2-05

Pump Tank: Gallons; PT Date

Pump Make: Model Serial No.

Nitrification Field: No Fields 1 Square Feet 1206 Linear Feet 40

No Lines 6@67' Trench Width 36" Max Trench Bottom Depth 36" Gravel Depth 12"

☑ New System ☐ Repair System Type: ~~CONVENTIONAL~~ LPP,

System Description: GRAVITY ~~CONVENTIONAL~~

Repair System Description: LP PANEL

Maintenance Agreement Required: ☐ Yes ☑ No

☑ House/Mod. Home No. Bedrooms 4S

☐ Mobile Home No. Bathrooms 3

☐ Business No. Employees

☐ Other


☐ Slab ☑ Crawl Space ☐ Basement w/plumbing ☐ Basement wo/plumbing

Water Supply: ☑ Individual ☐ Public ☐ Community


Comments:/Conditions:

Comments:/Conditions: SEPTIC TANK WITH MARKER INSTALLED USING "TUFFITE" FILTER

INITIAL SITE SKETCH 1"=50'

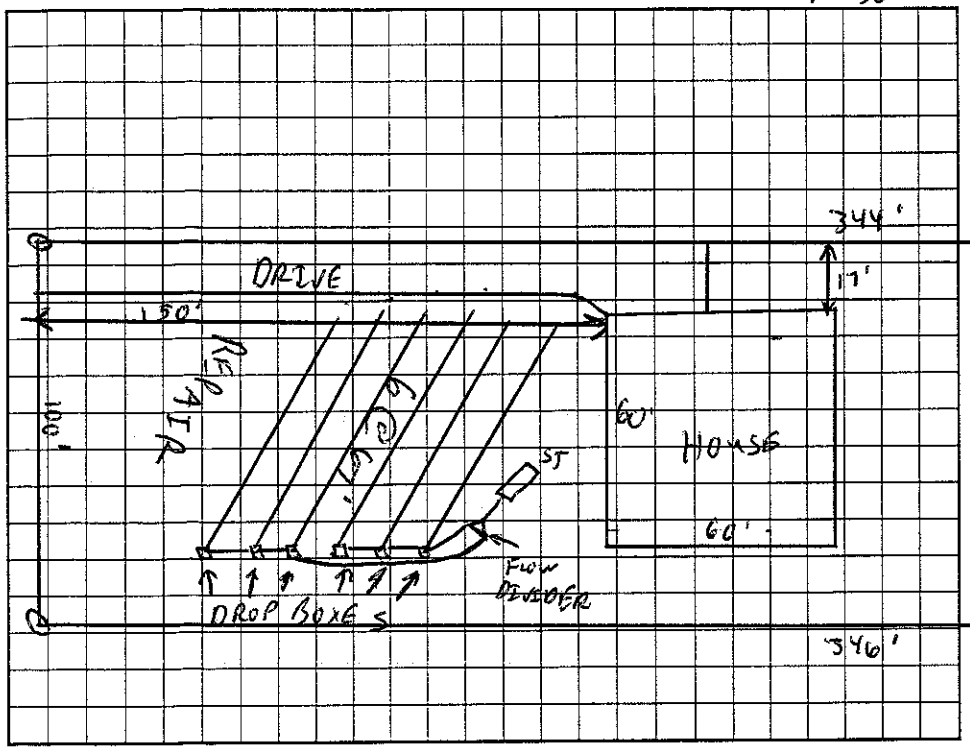

AS BUILT SKETCH

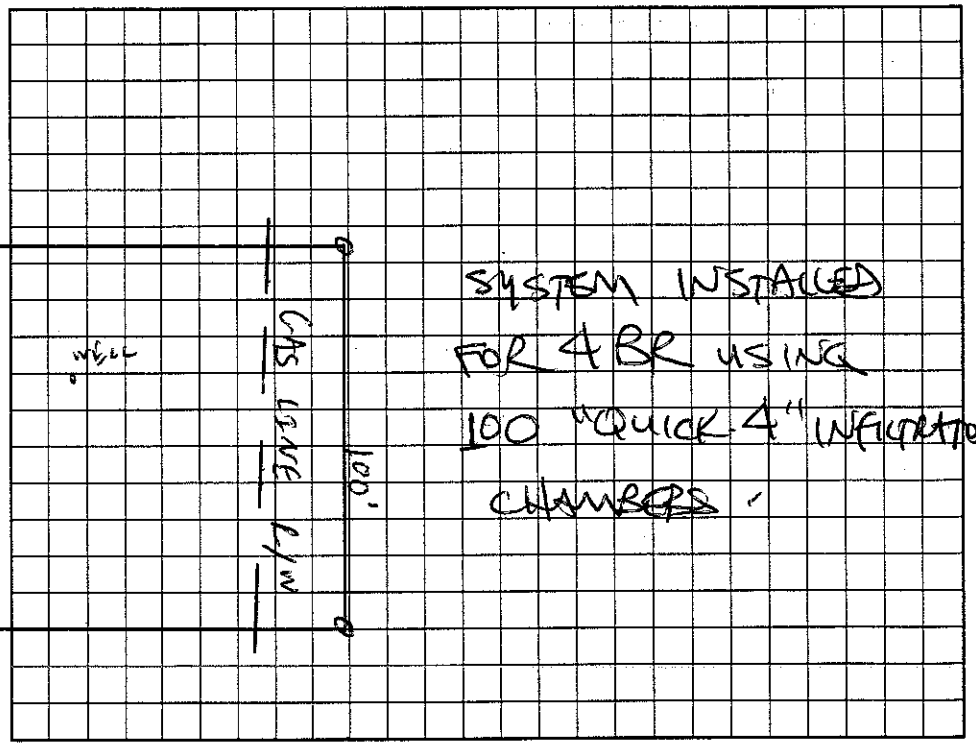

Permit can be suspended or revoked if any false information is supplied toward securing the permit/any unauthorized changes are made to the site/any unauthorized changes are made in the installation of the system. Improvement Permit with plat valid without expiration. Improvement Permit with site plan valid for sixty months. Authorization to Construct is valid for a period equal to that of Improvement Permit – not to exceed sixty months.

Signed: date 10/8/01

Improvement Permit by: C. Lee Team IRS date 7/27/01

Authorization to Construct by: date 8-3-05

Installed by: A-1 BACKHOE

Operation Permit by: STEVE HENDRICK date 11-15-05

Existing System Inspection by: date

HEALTH DEPT. COPY: WHITE OWNER COPY (FINAL): YELLOW OWNER COPY (INITIAL): PINK