*THIS PERMIT VOIDS PREVIOUSLY ISSUED PERMIT ON 07/24/02

IREDELL COUNTY HEALTH DEPARTMENT

STATESVILLE 704-878-5305 MOORESVILLE 704-664-5281

IMPROVEMENT PERMIT / AUTHORIZATION TO CONSTRUCT / OPERATION PERMIT / EXISTING SYSTEM INSPECTION

PERMIT# 100556 PIN# 4741-76-8148 4741-78-8857 DATE 09/24/02

OWNER OR CONTRACTOR WILLIAM BREWSTER PHONE: Business 704-895-0556 Home DOUG JOHNSON 704-400-5066

ADDRESS P.O. BOX 99 DAVIDSON, NC 28036

LOCATION 21 SOUTH, (L) MURDOCK RD, (R) HOOVER, (L) MARTHA'S VINEYARD (L) PAINTED BUNTING, LOT ON RIGHT.

SUBDIVISION MARTHAS VINEYARD BLOCK / SECTION 2 LOT 7 LOT AREA 1.07 ACRES SITE CLASS. PS DESIGN FLOW 480 GPD L.T.A.R. 0.25 GPD/FT²

Septic Tank: 1,000 Gallons; STB 1012 Date 08/24/02
Pump Tank: ____ Gallons; PT ____ Date ____
Pump Make: ____ Model ____ Serial No. ____
Nitrification Field: No Fields 1 Square Feet 1,920 Linear Feet 480
No Lines 8 x 60' Trench Width 36" Max Trench Bottom Depth 36"

X New System ☐ Repair System Type: I, II, (III), IV, V, VI
System Description: GRAVITY, 25% REDUCTION
Repair System Description: LOW PRESSURE, 50% REDUCTION
Maintenance Agreement Required: ☐ Yes X No
Gravel Depth N/A ☐ Slab X Crawl Space ☐ Basement w/plumbing ☐ Basement wo/plumbing


X House/Mod. Home ☐ Mobile Home ☐ Business ☐ Other
No. Bedrooms 4 No. Bathrooms 3 No. Employees ____

Water Supply: X Individual ☐ Public ☐ Community
WELL


Comments/Conditions: (1) INSTALL SYSTEM AS SHOWN (SEE ATTACHED SHEET FOR MORE DETAILED SKETCH), (2) INSTALL LINES ON CONTOUR, (3) MAINTAIN ALL SETBACKS (4) WELL MUST BE 100 FEET FROM SYSTEM

Comments/Conditions: -SEPTIC TANK INSTALLED USING TUFF-TIGHT-FILTER & TANK MARKER.
*SYSTEM INSTALLED DURING PERIOD OF WET SOIL CONDITIONS.

INITIAL SITE SKETCH

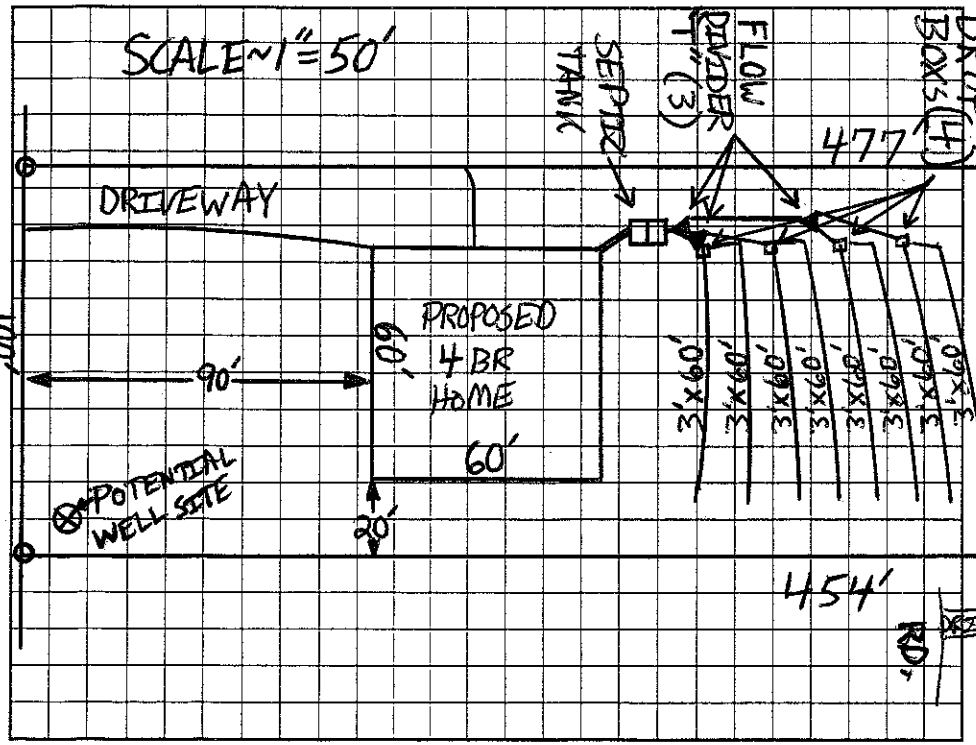

AS BUILT SKETCH

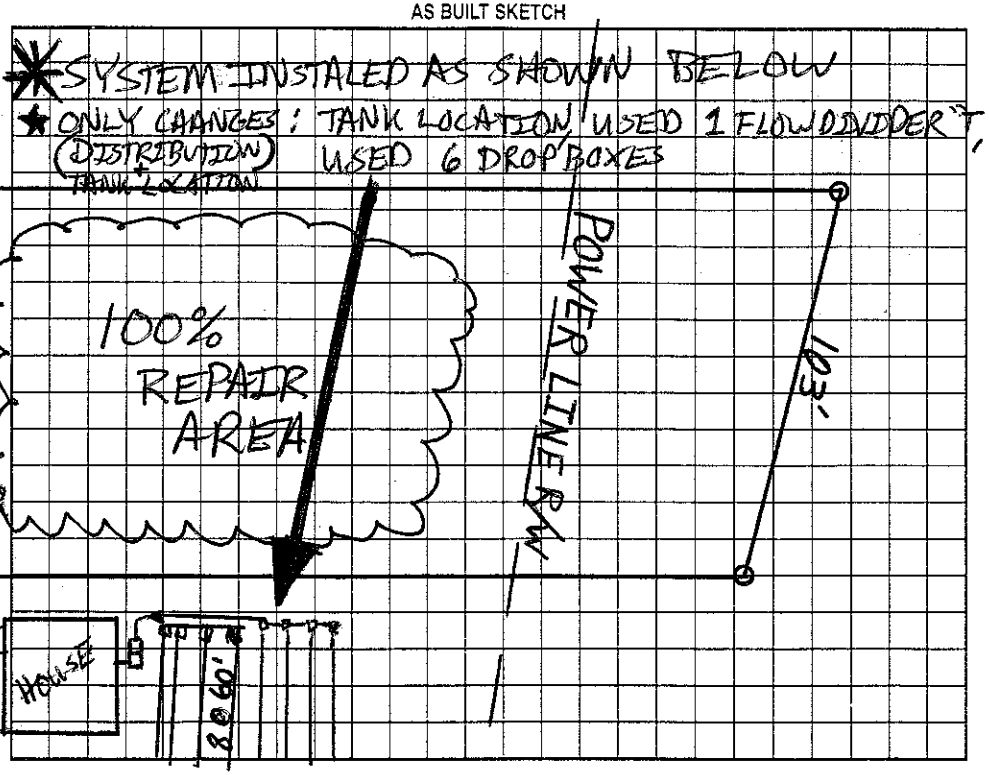

Permit can be suspended or revoked if any false information is supplied toward securing the permit/any unauthorized changes are made to the site/any unauthorized changes are made in the installation of the system. Improvement Permit with plat valid without expiration. Improvement Permit with site plan valid for sixty months. Authorization to Construct is valid for a period equal to that of Improvement Permit – not to exceed sixty months.

Signed: Angie Blount date 10/4/02 Installed by: A-1 BACKHOE - 03/04/03

Improvement Permit by: Patrick Mitchell date 09/24/02 Operation Permit by: Patrick Mitchell date 03/17/03

Authorization to Construct by: Patrick Mitchell date 09/24/02 Existing System Inspection by: ____ date ____

HEALTH DEPT. COPY: WHITE OWNER COPY (FINAL): YELLOW OWNER COPY (INITIAL): PINK