IREDELL COUNTY HEALTH DEPARTMENT

STATESVILLE 704-878-5305 (el) MOORESVILLE 704-664-5281

IMPROVEMENT PERMIT / AUTHORIZATION TO CONSTRUCT / OPERATION PERMIT / EXISTING SYSTEM INSPECTION

PERMIT# 1000602 (1000592) PIN# 4741-78-9462 DATE 6-9-04

OWNER OR CONTRACTOR WILLIAM BREWSTER PHONE: Business 704-895-0556 Home 704-400-5066 (DOUG JOHNSON)

ADDRESS P.O BOX 99, DAVIDSON, NC 28036

LOCATION US 21S, TL MURDOCK RD, TR HOOVER, TL MARTHA'S VINEYARD, TR PAINTED BUNTING, 1ST LOT ON LEFT PAST SCARLET TANAGER

SUBDIVISION MARTHA'S VINEYARD BLOCK / SECTION II LOT 11 LOT AREA 0.863 ACRE SITE CLASS. PS DESIGN FLOW 600 L.T.A.R. 0.30 GPD/FT²

Septic Tank: 1500 Gallons; STB 1011 Date 1-4-04

Pump Tank: _____ Gallons; PT _____ Date _____

Pump Make: _____ Model _____ Serial No. _____

Nitrification Field: No Fields 1 Square Feet EFT 2000 Linear Feet 500

No Lines FIVE Trench Width 36" Max Trench Bottom Depth 36" Gravel Depth N/A

☑ New System ☐ Repair System Type: I, II, III, IV, V, VI

System Description: 25% REDUCTION, GRAVITY

Repair System Description: 50% REDUCTION, LOW PRESSURE

Maintenance Agreement Required: ☐ Yes ☑ No

☑ House/Mod. Home No. Bedrooms 5

☐ Mobile Home No. Bathrooms 2.5

☐ Business No. Employees ____

☐ Other _____


☐ Slab ☑ Crawl Space ☐ Basement w/plumbing ☐ Basement wo/plumbing

Water Supply: ☑ Individual ☐ Public ☐ Community WELL


Comments:/Conditions: INSTALL 25% REDUCTION SYSTEM IN FIVE LINES ON CONTOUR AS SHOWN. KEEP SYSTEM MINIMUM 100 FEET FROM WELL.

Comments:/Conditions: SEPTIC TANK WITH MARKER INSTALLED USING "TUFTITE" FILTER

INITIAL SITE SKETCH

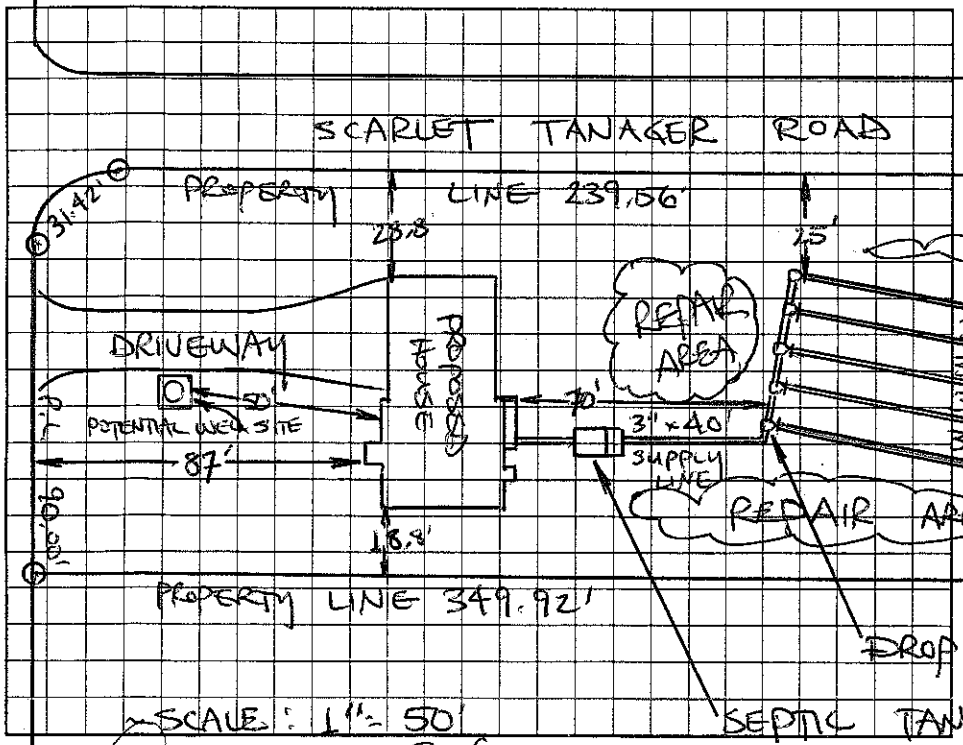

AS BUILT SKETCH

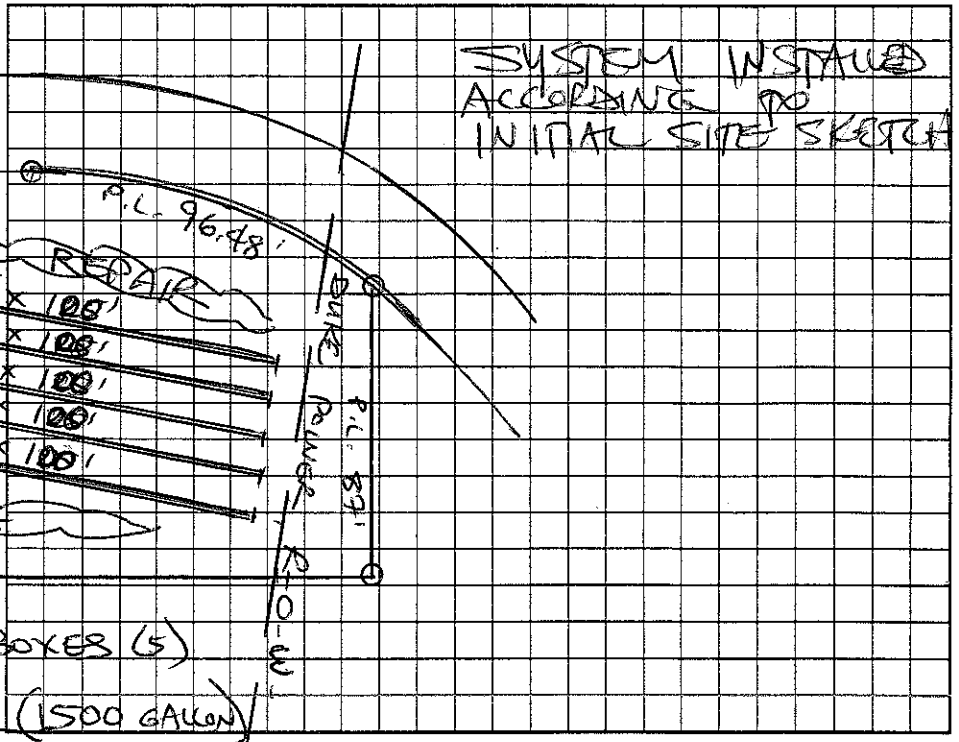

Permit can be suspended or revoked if any false information is supplied toward securing the permit/any unauthorized changes are made to the site/any unauthorized changes are made in the installation of the system. Improvement Permit with plat valid without expiration. Improvement Permit with site plan valid for sixty months. Authorization to Construct is valid for a period equal to that of Improvement Permit – not to exceed sixty months.

Signed: _____ date 6/11/04 Installed by: A-1 BACKHOE

Improvement Permit by: STEVE HENDRICK date 6-9-04 Operation Permit by: STEVE HENDRICK date 2-16-05

Authorization to Construct by: STEVE HENDRICK date 6-9-04 Existing System Inspection by: _____ date _____

HEALTH DEPT. COPY: WHITE OWNER COPY (FINAL): YELLOW OWNER COPY (INITIAL): PINK