IREDELL COUNTY HEALTH DEPARTMENT

STATESVILLE 704-878-5305 CI MOORESVILLE 704-664-5281

IMPROVEMENT PERMIT / AUTHORIZATION TO CONSTRUCT / OPERATION PERMIT / EXISTING SYSTEM INSPECTION

PERMIT# 100565 PIN# ~~4741-78-8148 (PE)~~ 4741-78-9549 DATE 05/09/03

OWNER OR CONTRACTOR WILLIAM BREWSTER Co. PHONE: Business 704-895-0556 Home ~~704-664-7166~~ 704-400-5066

ADDRESS P.O. BOX 99 DAVIDSON NC 28036

LOCATION 21 SOUTH, (L) MURDOCH, (R) HOOVER, (L) MARTHAS VINEYARD, (R) PAINTED BUNTING, (L) SCARLET LOT ON LEFT CORNER,

SUBDIVISION MARTHAS VINEYARD BLOCK / SECTION 2 LOT 10 LOT AREA 0.96 ACRES SITE CLASS. PS DESIGN FLOW 480 GPD L.T.A.R. 0.30 GPD/FT²

Septic Tank: 1,000 Gallons; STB 1012 Date 2-17-03
Pump Tank: _____ Gallons; PT _____ Date _____
Pump Make: _____ Model _____ Serial No. _____
Nitrification Field: No Fields 1 Square Feet EQ to 1,600 Linear Feet 270
No Lines 6 @ 45' Trench Width 24" Max Trench Bottom Depth 36" Gravel Depth NA

X New System ☐ Repair System Type: I, II, (III), IV, V, VI
System Description: 50% REDUCTION, GRAVITY
Repair System Description: SAME
Maintenance Agreement Required: ☐ Yes X No

X House/Mod. Home No. Bedrooms 4
☐ Mobile Home No. Bathrooms 2½
☐ Business No. Employees _____
☐ Other _____


X Slab ☐ Crawl Space ☐ Basement w/plumbing X Basement wo/plumbing

Water Supply: X Individual ☐ Public ☐ Community WELL

Comments:/Conditions: (1) INSTALL SYSTEM USING 10 PANELS PER LINE (60 PANELS TOTAL TO EQUAL 270'). (2) INSTALL SYSTEM USING 1 FLOW DIVIDER "T" & 2 DISTRIBUTION BOXES WITH SPEED LEVELERS TO ACHIEVE EQUAL DISTRIBUTION.

Comments:/Conditions: (3) DO NOT EXCAVATE BEYOND POINT SHOWN ON DRAWING.
– Tuff – Type Filter & ST marker Installed

INITIAL SITE SKETCH

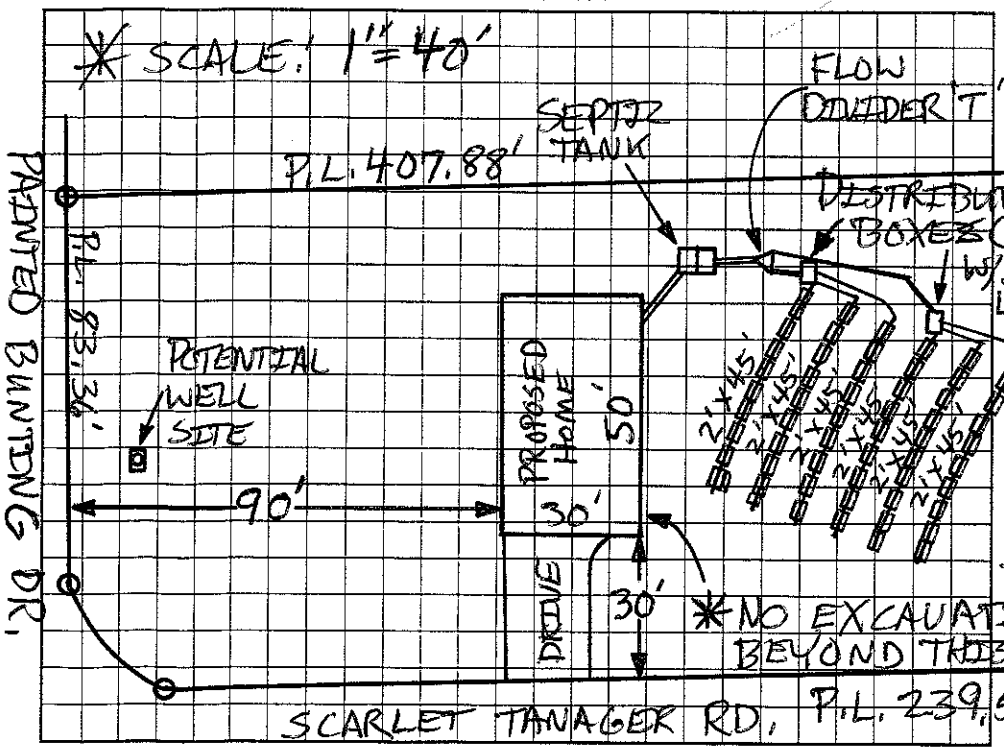

AS BUILT SKETCH

(Driveway front entrance instead of side entrance)

Installed

As Shown

per Initial Site Sketch

Permit can be suspended or revoked if any false information is supplied toward securing the permit/any unauthorized changes are made to the site/any unauthorized changes are made in the installation of the system. Improvement Permit with plat valid without expiration. Improvement Permit with site plan valid for sixty months. Authorization to Construct is valid for a period equal to that of Improvement Permit – not to exceed sixty months.

Signed: Angie Blount date 5/14/03 Installed by: A-1 Backhoe

Improvement Permit by: Patrick Mitchell date 05/09/03 Operation Permit by: William O. Josh date 9-12-03

Authorization to Construct by: Patrick Mitchell date 05/09/03 Existing System Inspection by: _____ date _____

HEALTH DEPT. COPY: WHITE OWNER COPY (FINAL): YELLOW OWNER COPY (INITIAL): PINK