IREDELL COUNTY HEALTH DEPARTMENT

STATESVILLE 704-878-5305 MOORESVILLE 704-664-5281

IMPROVEMENT PERMIT / AUTHORIZATION TO CONSTRUCT / OPERATION PERMIT / EXISTING SYSTEM INSPECTION

PERMIT# 100557 PIN# 4741-78-~~8118 PT~~ 9608 DATE 12-15-03

OWNER OR CONTRACTOR William BREWSTER PHONE: Business 704-895-0556 Home

ADDRESS PO BOX 99 DAVIDSON NC 28036

LOCATION 77 SOUTH, (R) AMITY HILL (L) MCCODLE (L) HOOVER (L) MARTHA VINEYARD (R) DAVIDSON BUTNER, ON LEFT #9

SUBDIVISION MARTHA'S VINEYARD BLOCK / SECTION 2 LOT 9 LOT AREA .96 AC SITE CLASS. PS DESIGN FLOW 480 L.T.A.R. .3

Septic Tank: 1000 Gallons; STB 1012 Date 8-5-03
Pump Tank: _____ Gallons; PT _____ Date _____
Pump Make: _____ Model _____ Serial No. _____
Nitrification Field: No Fields 1 Square Feet EA=1600' Linear Feet 400'
No Lines 6x67' Trench Width 36" Max Trench Bottom Depth 36" Gravel Depth N/A

[X] New System [ ] Repair System Type: I, II, (III), IV, V, VI
System Description: 60% / 250% REDUCT
Repair System Description: SAME
Maintenance Agreement Required: [ ] Yes [X] No


[X] House/Mod. Home No. Bedrooms 4
[ ] Mobile Home No. Bathrooms 3
[ ] Business No. Employees ____
[ ] Other _____
[ ] Slab [X] Crawl Space [ ] Basement w/plumbing [ ] Basement wo/plumbing

Water Supply: [X] Individual [ ] Public [ ] Community

Comments:/Conditions: (1) THIS IS A REDRAW AREA/LALES PREVIOUSLY ISSUED PERMIT DATED 7/25/01 (2) NEW PERMIT DESIGNED OFF OLD PERMIT BY JUST CHANGING SYSTEM TYPES.

Comments:/Conditions: (3) INSTALL LINES ON CONTOURS (4) MAINTAIN SETBACKS (5) INSTALL 6 LINES/67' LONG AS DRAWN USING A FLOW DIVIDER TEE.


INITIAL SITE SKETCH 1" = 50'

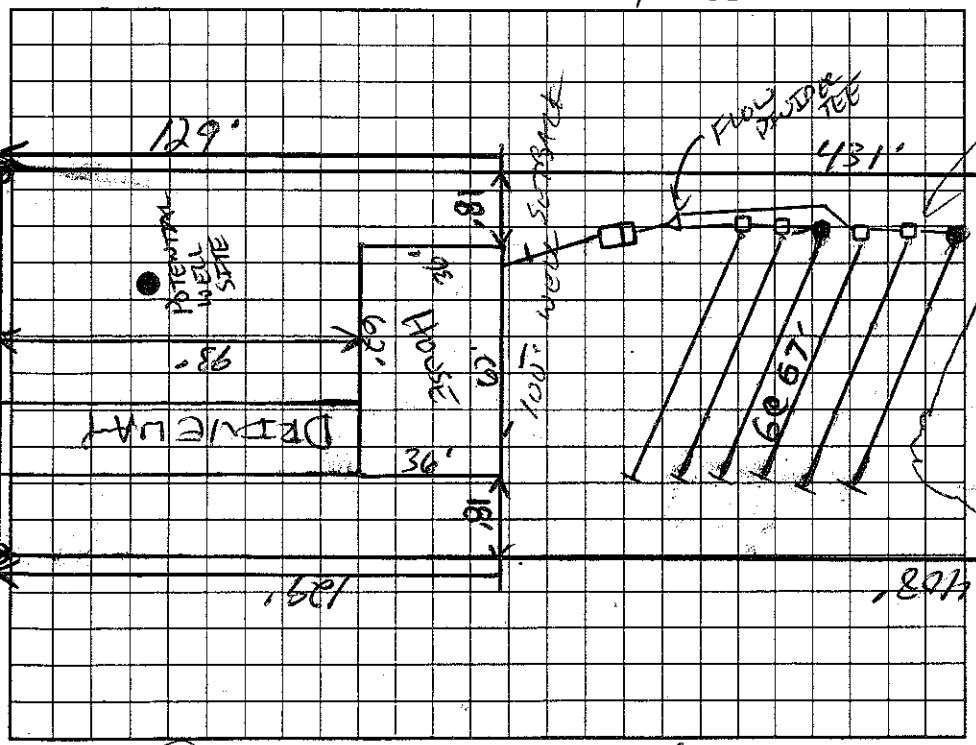

AS BUILT SKETCH

4 BOXES INSTALLED

TUFF-TITE FILTER & MARKER. WELL NOT INSTALLED AT TIME OF CHECK. HOUSE NOT FINISHED EITHER. JUST THE FOUNDATION

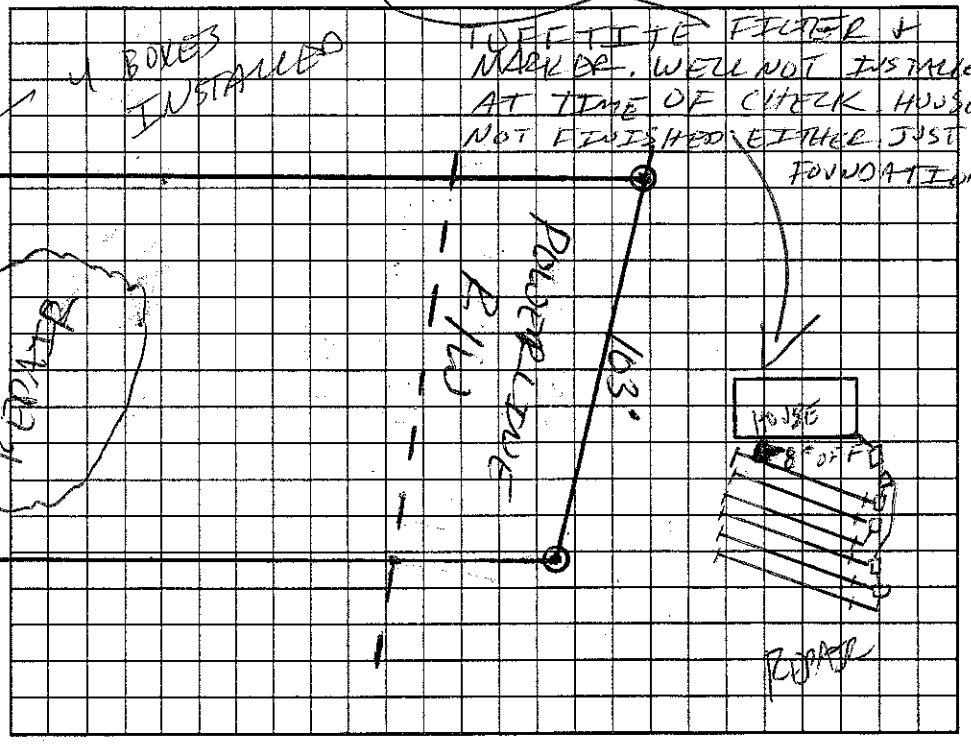

Permit can be suspended or revoked if any false information is supplied toward securing the permit/any unauthorized changes are made to the site/any unauthorized changes are made in the installation of the system. Improvement Permit with plat valid without expiration. Improvement Permit with site plan ~~valid for~~ sixty months. Authorization to Construct is valid for a period equal to that of Improvement Permit – not to exceed sixty months.

Signed: Angie Brown date 12-15-03 Installed by: A-1 BACKHOE

Improvement Permit by: [signature] date 12-15-03 Operation Permit by: [signature] date 1-15-04

Authorization to Construct by: [signature] date 12-15-03 Existing System Inspection by: _____ date _____

HEALTH DEPT. COPY: WHITE OWNER COPY (FINAL): YELLOW OWNER COPY (INITIAL): PINK