IREDELL COUNTY HEALTH DEPARTMENT

STATESVILLE 704-878-5305 MOORESVILLE 704-664-5281

IMPROVEMENT PERMIT / AUTHORIZATION TO CONSTRUCT / OPERATION PERMIT / EXISTING SYSTEM INSPECTION

PERMIT# 100553 PIN# 4741 784148 PT DATE 7/20/01

OWNER OR CONTRACTOR WILLIAM BREWSTER PHONE: Business 895-0556 Home

ADDRESS PO BOX 99 · DAVIDSON · NC 28036

LOCATION 21S - TL MURDOCK · TR HOOVER - TL MARTHA'S VINEYARD - TL PAINTED BUNTING - AT END


SUBDIVISION MARTHA'S VINEYARD BLOCK / SECTION LOT 4 LOT AREA 1.43 AC SITE CLASS PS DESIGN FLOW 360GPD L.T.A.R. .30 PDIFF

Septic Tank: 1000 Gallons: STB 825 Date 06/05/02	~~New System~~ ☐ Repair System Type: I (II) III IV V VI	~~House/Mod Home~~ No. Bedrooms 3	Water Supply: ~~Individual~~ ☐ Public ☐ Community
Pump Tank: Gallons: PT Date	System Description: GRAVITY CONVENTIONAL	☐ Mobile Home No. Bathrooms 3	
Pump Make: Model Serial No	Repair System Description: SAME	☐ Business No. Employees	
Nitrification Field: No Fields 1 Square Feet 1200 Linear Feet 400	Maintenance Agreement Required: ☐ Yes ~~No~~	☐ Other	
No Lines ~~5~~ 4 x 100' Trench Width 36" Max Trench Bottom Depth 36"	Gravel Depth 12"	☐ Slab ☒ Crawl Space ☐ Basement w/plumbing ☐ Basement wo/plumbing	WELL

Comments/Conditions:


Comments/Conditions: - SEPTIC TANK INSTALLED USING MARKER + POLY-LOC FILTER

INITIAL SITE SKETCH 1" = 50'

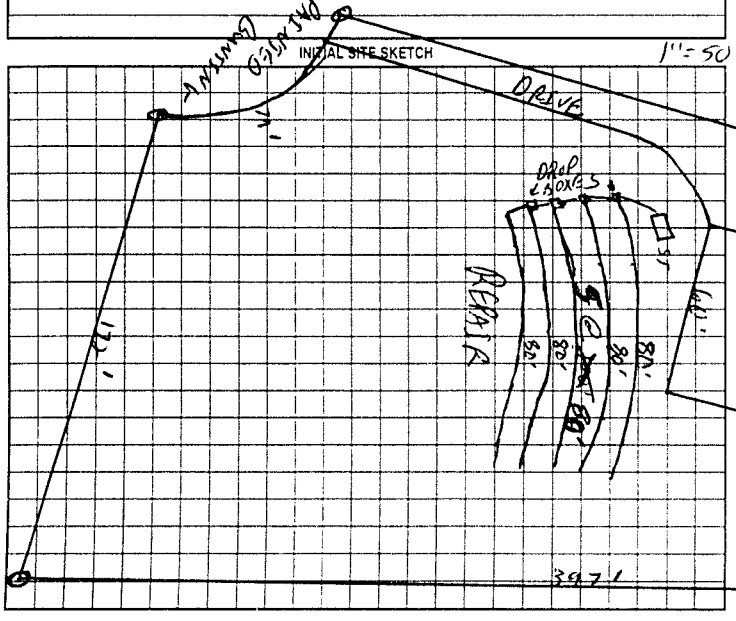

AS BUILT SKETCH

- SYSTEM INSTALLED AS SHOWN IN INITIAL SITE SKETCH

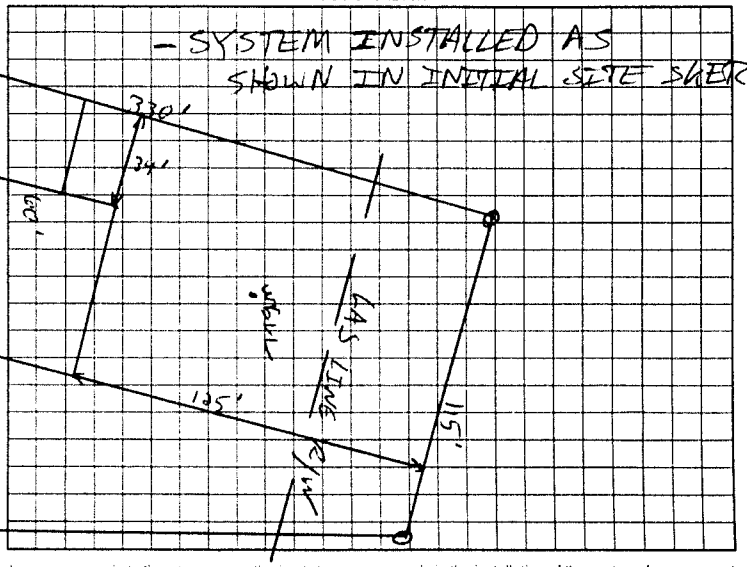

Permit can be suspended or revoked if any false information is supplied toward securing the permit; any unauthorized changes are made to the site; any unauthorized changes are made in the installation of the system. Improvement Permit with plat valid without expiration. Improvement Permit with site plan valid for sixty months. Authorization to Construct is valid for a period equal to that of Improvement Permit - not to exceed sixty months.

Signed: [signature] date 10/8/01 Installed by: JOE THOMSON GRADING + SEPTIC

Improvement Permit by: [signature] date 7/20/01 Operation Permit by: [signature] date 09/10/02

Authorization to Construct by: [signature] date 6/18/02 Existing System Inspection by: date

HEALTH DEPT COPY WHITE OWNER COPY (FINAL) YELLOW OWNER COPY (INITIAL) PINK