IREDELL COUNTY HEALTH DEPARTMENT

per 50.0 per This permit voids previously issued permit dated 9/24/01

STATESVILLE 704-878-5305 MOORESVILLE 704-664-5281

IMPROVEMENT PERMIT / AUTHORIZATION TO CONSTRUCT / OPERATION PERMIT / EXISTING SYSTEM INSPECTION

PERMIT# 100554 PIN# ~~4744-28-8448-PF~~ 4744.19-6052 DATE 8/21/03

OWNER OR CONTRACTOR William Brewster PHONE: Business 895-0556 Home —

ADDRESS PO Box 99 Davidson NC 28036

LOCATION 21 South, ⓒ Murdock, ⓡ Hoover, ⓛ Martha's Vineyard, ⓡ Painted Bunting @ cul-de-sac

SUBDIVISION Martha's Vineyard BLOCK / SECTION — LOT 5 LOT AREA 1.63Ac SITE CLASS. PS DESIGN FLOW 360 L.T.A.R. .3 spd/ft2

Septic Tank: 1,000 Gallons; STB 1012 Date 1-26-03

Pump Tank: 1,000 Gallons; PT 17 Date 12-5-03

Pump Make: Goulds Model WE0311M Serial No. M025625?

Nitrification Field: No Fields 1 Square Feet Eq. to 1200 Linear Feet 300

No Lines 3@100' Trench Width 36" Max Trench Bottom Depth 36" Gravel Depth NA

☒ New System ☐ Repair System Type: I, II, III, IV, V, VI

System Description: Pump, 25% Reduction

Repair System Description: Pump, 50% Reduction

Maintenance Agreement Required: ☐ Yes ☒ No

☒ House/Mod. Home ☐ Mobile Home ☐ Business ☐ Other

No. Bedrooms 3 No. Bathrooms 2 No. Employees —

☐ Slab ☒ Crawl Space ☐ Basement w/plumbing ☐ Basement wo/plumbing

Water Supply: ☒ Individual ☐ Public ☐ Community


Comments:/Conditions: ① Keep well 100ft from Septic System 330'

② Install 6" Sch 80 pipe under Driveway where Supply Line crosses.


Comments:/Conditions: 113'

- 48 Infi Hector chambers Installed
- ST marker + Tuff-Tite filter Installed
- Lines checked okay 8/21/03
- pressure check electrical + Alarm Okay.

INITIAL SITE SKETCH

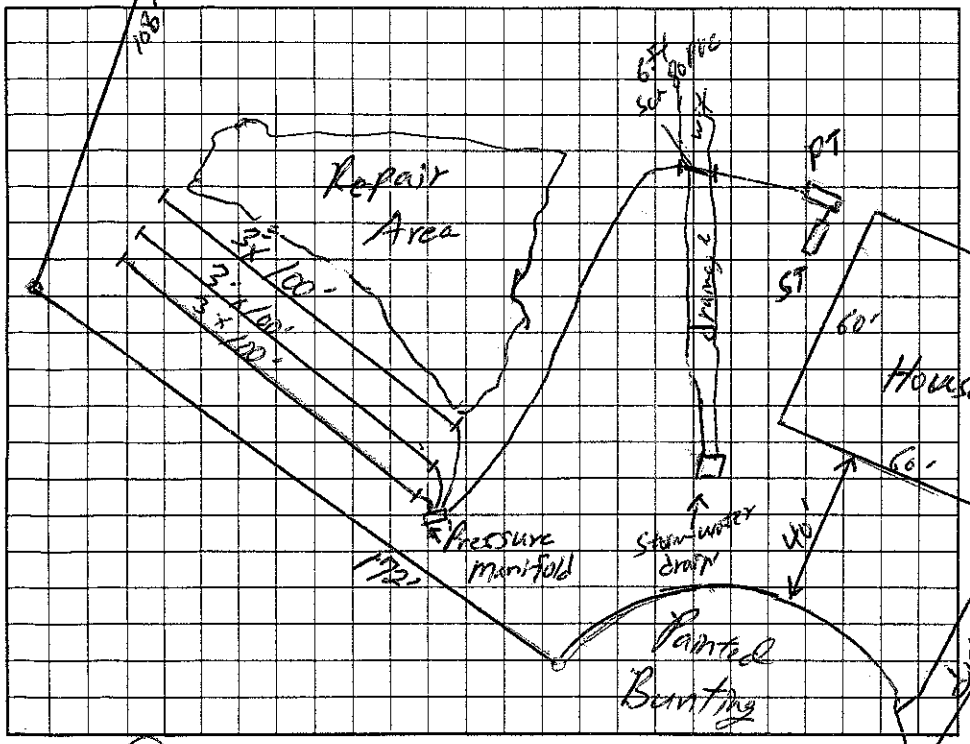

AS BUILT SKETCH

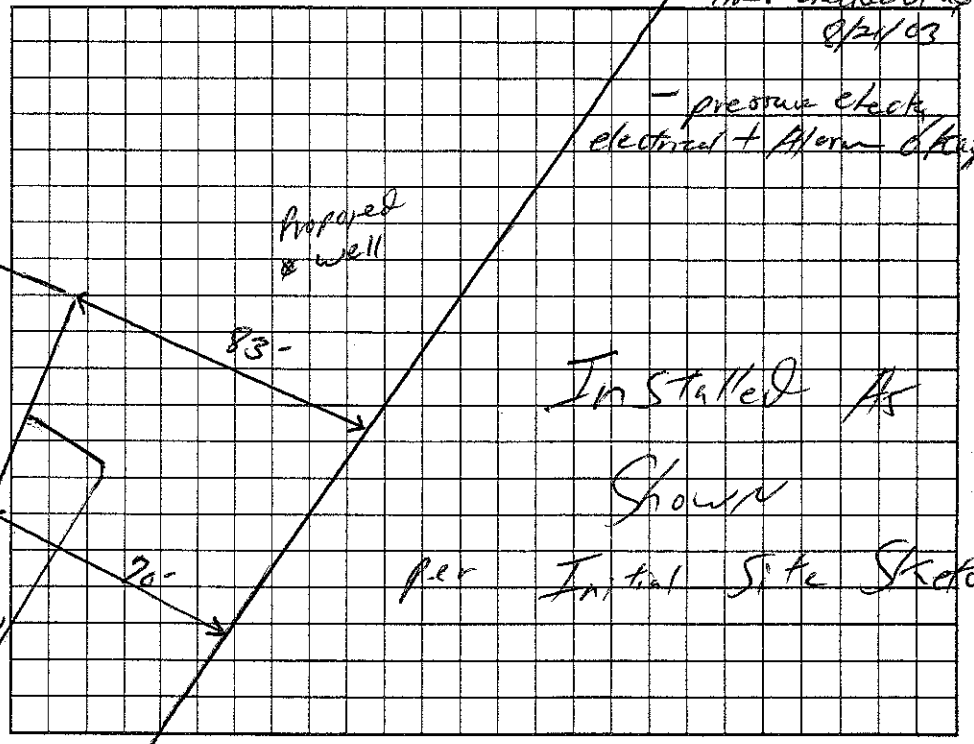

Permit can be suspended or revoked if any false information is supplied toward securing the permit/any unauthorized changes are made to the site/any unauthorized changes are made in the installation of the system. Improvement Permit with plat valid without expiration. Improvement Permit with site plan valid for sixty months. Authorization to Construct is valid for a period equal to that of Improvement Permit -- not to exceed sixty months.

Signed: Angie Blount date 9/15/03 Installed by: A-1 Backhoe (8/21/03)

Improvement Permit by: William O. Johnson date 8/21/03 Operation Permit by: William O. Johnson date —

Authorization to Construct by: William O. Johnson date 8/21/03 Existing System Inspection by: — date —

HEALTH DEPT. COPY: WHITE OWNER COPY (FINAL): YELLOW OWNER COPY (INITIAL): PINK