IREDELL COUNTY HEALTH DEPARTMENT

STATESVILLE 704-878-5305 MOORESVILLE 704-664-5281

IMPROVEMENT PERMIT / AUTHORIZATION TO CONSTRUCT / OPERATION PERMIT / EXISTING SYSTEM INSPECTION

PERMIT# 88151 PIN# 4741 81 4551 DATE 3-21-00

OWNER OR CONTRACTOR Charles Torrence PHONE: Business _____ Home _____

ADDRESS 847 Perry Rd Troutman

LOCATION 215 TL Oswalt Amity TL Perry Rd 1/4mi on left.

SUBDIVISION Pollard Cowan BLOCK / SECTION _____ LOT 1 LOT AREA .162 acres SITE CLASS PS DESIGN FLOW 360 L.T.A.R. .3

Property

Septic Tank: 1000 Gallons: STB 1012 Date 12-3-99
Pump Tank: _____ Gallons: PT _____ Date _____
Pump Make: _____ Model _____ Serial No. _____
Nitrification Field: No Fields 4 Square Feet 1200 Linear Feet 400
No Lines 5 Trench Width 36" Max Trench Bottom Depth 36" Gravel Depth 12"

☑ New System ☐ Repair System Type: I, II, III, IV, V, VI
System Description: Conv. Gravity
Repair System Description: Gravity 25% rdn.
Maintenance Agreement Required: ☐ Yes ☑ No


☐ House/Mod. Home No. Bedrooms 3
☐ Mobile Home No. Bathrooms 2
☐ Business No. Employees ____
☐ Other _____
☐ Slab ☐ Crawl Space ☐ Basement w/plumbing ☐ Basement wo/plumbing

Water Supply: ☑ Individual ☐ Public ☐ Community


Comments:/Conditions:

Comments:/Conditions.

INITIAL SITE SKETCH

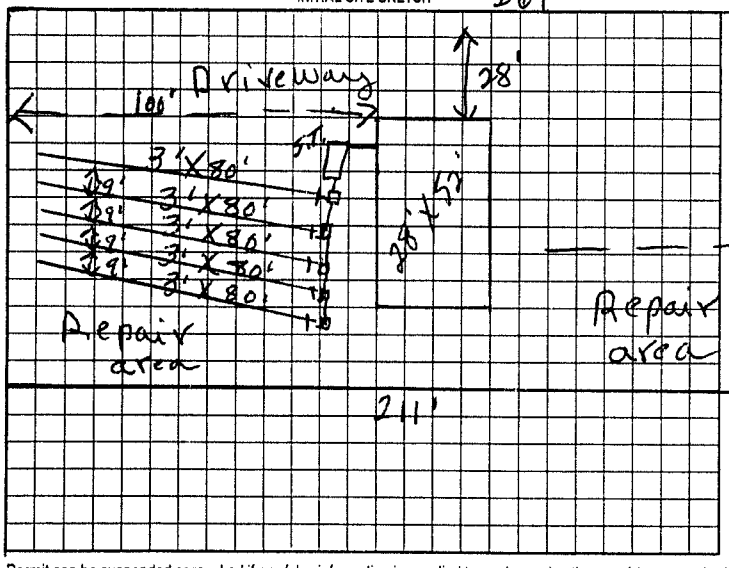

AS BUILT SKETCH

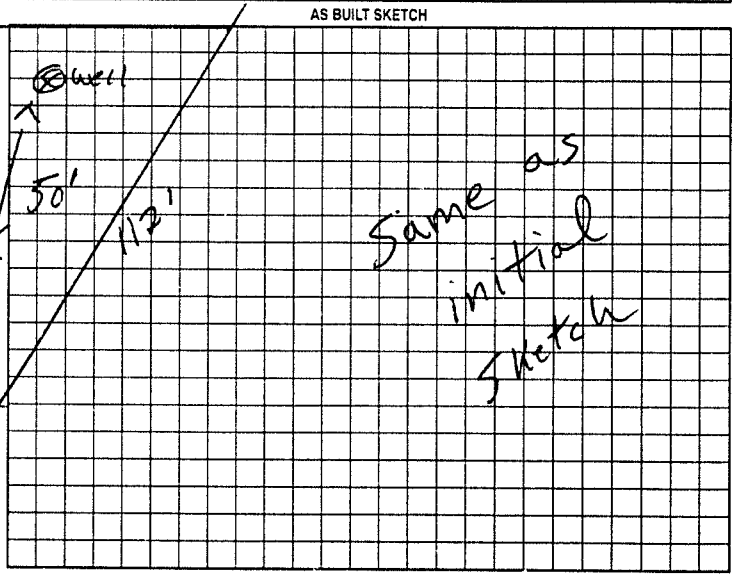

Permit can be suspended or revoked if any false information is supplied toward securing the permit/any unauthorized changes are made to the site/any unauthorized changes are made in the installation of the system. Improvement Permit with plat valid without expiration. Improvement Permit with site plan valid for sixty months. Authorization to Construct is valid for a period equal to that of Improvement Permit – not to exceed sixty months.

Signed: X. Charles Torrence date _____ Installed by: A-1 Backhoe

Improvement Permit by: P. C. Moore date 3-21-00 Operation Permit by: P. C. Moore date 3-27-00

Authorization to Construct by: P. C. Moore date 3-21-00 Existing System Inspection by: _____ date _____

HEALTH DEPT. COPY: WHITE OWNER COPY (FINAL) YELLOW OWNER COPY (INITIAL) PINK