IREDELL COUNTY HEALTH DEPARTMENT

STATESVILLE 704-878-5305 MOORESVILLE 704-664-5281

IMPROVEMENT PERMIT / AUTHORIZATION TO CONSTRUCT / OPERATION PERMIT / EXISTING SYSTEM INSPECTION

PERMIT# 88659 PIN# 4741 81 4551 PT DATE 5/11/00

OWNER OR CONTRACTOR JERRY TORRENCE PHONE: Business _____ Home 528-4083

ADDRESS 847 PEACH RD - TROUTMAN

LOCATION 21 S - TL OSWALT AMITY - TL PERRY - .25 MILES ON LT

SUBDIVISION MILLARD COWAN BLOCK / SECTION _____ LOT 2 LOT AREA .68AC SITE CLASS. B DESIGN FLOW 360gpd L.T.A.R. .3gpd/ft²

Septic Tank: 1000 Gallons; STB 1012 Date 2 800

Pump Tank: _____ Gallons; PT _____ Date _____

Pump Make: _____ Model _____ Serial No _____

Nitrification Field: No Fields 1 Square Feet 1200 Linear Feet 400

No Lines 5@80' Trench Width 36" Max Trench Bottom Depth 36" Gravel Depth 12"

☑ New System ☐ Repair System Type: I (II) III. IV. V. VI

System Description: GRAVITY CONVENTIONAL

Repair System Description: GRAV/ PUMP INNOVATIVE

Maintenance Agreement Required: ☐ Yes ☑ No

☐ House/Mod. Home ☑ Mobile Home ☐ Business ☐ Other

No. Bedrooms 3 No. Bathrooms 3 No. Employees _____


☐ Slab ☐ Crawl Space ☐ Basement w/plumbing ☐ Basement wo/plumbing

Water Supply: ☑ Individual ☐ Public ☐ Community


Comments:/Conditions:

Comments:/Conditions:

INITIAL SITE SKETCH 1"=50'

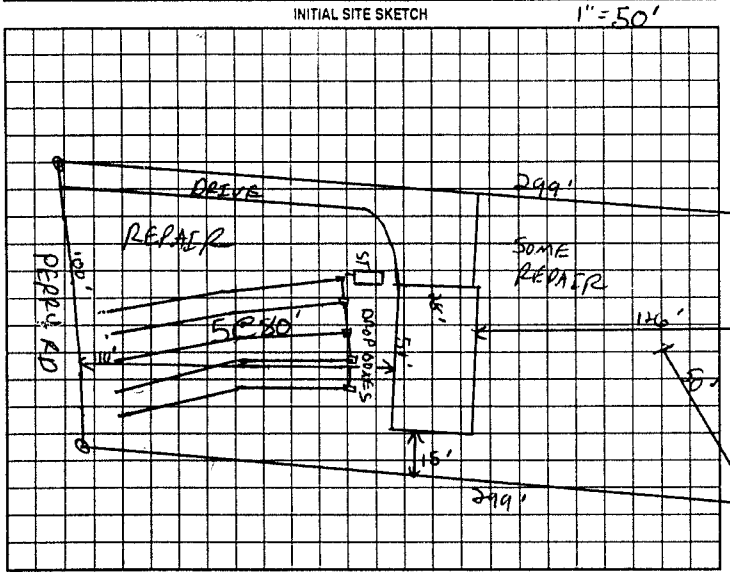

AS BUILT SKETCH

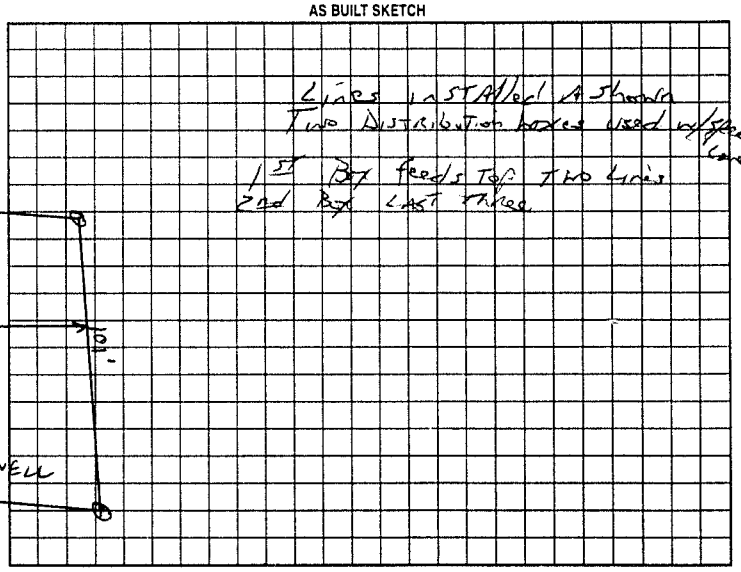

Permit can be suspended or revoked if any false information is supplied toward securing the permit/any unauthorized changes are made to the site/any unauthorized changes are made in the installation of the system. Improvement Permit with plat valid without expiration. Improvement Permit with site plan valid for sixty months. Authorization to Construct is valid for a period equal to that of Improvement Permit – not to exceed sixty months.

Signed: Jerry Torrence date _____

Improvement Permit by: C. [signature] KS date 5/11/00

Authorization to Construct by: C [signature] KS date 5/11/00

Installed by: Al Brackbee

Operation Permit by: [signature] Potter date June 14 2000

Existing System Inspection by: _____ date _____

HEALTH DEPT. COPY: WHITE OWNER COPY (FINAL): YELLOW OWNER COPY (INITIAL): PINK