IREDELL COUNTY HEALTH DEPARTMENT - *ENVIRONMENTAL HEALTH* ☑ STATESVILLE OFFICE 704-878-5305 ☐ MOORESVILLE OFFICE 704-664-5281

IMPROVEMENT PERMIT / AUTHORIZATION TO CONSTRUCT / OPERATION PERMIT / EXISTING SYSTEM INSPECTION

PERMIT # 170907 PIN # 4741-81-7025 DATE MARCH 23 2012

OWNER JULIA M. ALLISON APPLICANT: SAME PHONE: Home/Cell # 704-528-0968 Business # 704-239-3693

SITE ADDRESS 864 PERRY ROAD OWNER / APPLICANT ADDRESS P.O. BOX 267, TROUTMAN

SITE DIRECTIONS OSTWALT AMITY ROAD TO PERRY ROAD, 0.15 MILE ON LEFT

SUBDIVISION N/A BLOCK / SECTION N/A LOT # N/A LOT AREA LIMITED DESIGN FLOW 240 L.T.A.R. 0.20 GPD/FT²

Septic Tank 1000 Gallons: STB 760 Date 11/29/11 ☑ New System ☐ Repair ☐ Expansion System Type I (II) III IV V VI ☑ Residence No. Bedrooms 2 Water Supply ☑ Private WELL

Pump Tank ____ Gallons: P T ____ Date ____ System Description: 25% REDUCTION, GRAVITY ☐ Business No. Persons ____ ☐ Public

Pump Make ____ Model ____ Serial # ____ Repair System Description: 50% REDUCTION, LOW-PRESSURE ☐ Other No. Employees ____ ☐ Community


No. Nitrification Fields: 1 No. Lines 4 Linear Feet 300 Maintenance Agreement Required ☐ YES ☑ NO ☐ Slab ☑ Crawl Space

Trench Width 36" Max. Trench Bottom Depth 36" Gravel Depth N/A ☑ GRAVITY ☐ PRESSURE ☐ Basement w/plumbing ☐ Basement w/o plumbing

Comments / Conditions INSTALL 25% REDUCTION SYSTEM ON CONTOUR AS SHOWN. KEEP SYSTEM MINIMUM 100' FROM WELL, 5' FROM FOUNDATIONS, 10' FROM PROPERTY LINE

* SCOUR TRENCH SIDEWALLS WHERE SMEARING OCCURS —

INITIAL SITE SKETCH

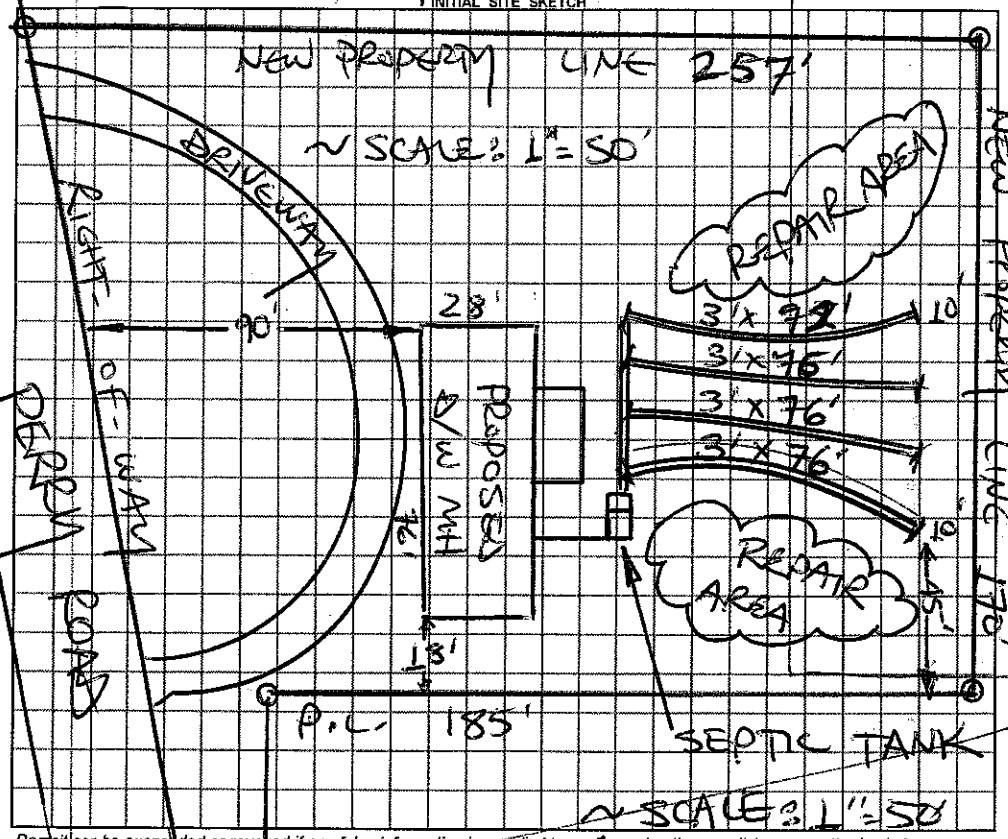

AS BUILT SKETCH

SYSTEM INSTALLED AS SHOWN USING 60 "BIOFILTER A36" CHAMBERS IN FOUR 3'x75' LINES. SEPTIC TANK WITH MARKER INSTALLED USING RED "POLYLOK" FILTER. SYSTEM SIZED FOR 2BR ONLY.

Permit can be suspended or revoked if any false information is supplied toward securing the permit / any unauthorized changes are made to the site / any unauthorized changes are made in the installation of the system.

☐ *IMPROVEMENT PERMIT with plat valid without expiration.* ☑ *IMPROVEMENT PERMIT with plat valid without expiration. site plan valid 60 mo.* ☑ *AUTHORIZATION TO CONSTRUCT* valid for period equal to IMPROVEMENT PERMIT--not to exceed 60 mo.

Owner / Applicant Signature: Julia Allee Date 3/29/12 Installed by: ABEE GRADING

IMPROVEMENT PERMIT by: STEVE HEDRICK REHS Date 3/23/12 OPERATION PERMIT by: STEVE HEDRICK REHS Date 4/11/12

AUTHORIZATION TO CONSTRUCT by: STEVE HEDRICK REHS Date 3/23/12 Existing System Inspected by: ____ REHS Date ____

YOU SHOULD CONTACT A LOCATOR SERVICE PRIOR TO ANY EXCAVATION

White Copy – Environmental Health YELLOW COPY (Final) Owner / Applicant PINK COPY (Initial) Owner / Applicant