IREDELL COUNTY HEALTH DEPARTMENT

STATESVILLE 704-878-5305 MOORESVILLE 704-664-5281

IMPROVEMENT PERMIT / AUTHORIZATION TO CONSTRUCT / OPERATION PERMIT / EXISTING SYSTEM INSPECTION

PERMIT# 83920 PIN# 4741818545 DATE 9-21-99

OWNER OR CONTRACTOR Millard Rydell Cowan PHONE: Business Home 528 4083

ADDRESS 847 Perry Rd Troutman N.C.

LOCATION 1155 TL Oswalt Amity TL Perry Rd 1/4 mi Rt.

SUBDIVISION BLOCK / SECTION LOT LOT AREA 1.0 acres SITE CLASS PS DESIGN FLOW 240 L.T.A.R. .33

Septic Tank: 1000 Gallons; STB 6786 Date 6-8-99
Pump Tank: Gallons; PT Date
Pump Make: Model Serial No.
Nitrification Field: No Fields 1 Square Feet 720 Linear Feet 240
No Lines 3 Trench Width 36" Max Trench Bottom Depth 36" Gravel Depth 12"

New System Repair System Type: I II III IV V VI
System Description: Conv. Gravity
Repair System Description: Gravity 25% Reduction
Maintenance Agreement Required: Yes No

House/Mod. Home No. Bedrooms 2
Mobile Home No. Bathrooms 2
Business No. Employees
Other
Slab Crawl Space Basement w/plumbing Basement wo/plumbing


Water Supply: Individual Public Community

Comments/Conditions:


148.49'

Comments/Conditions

INITIAL SITE SKETCH

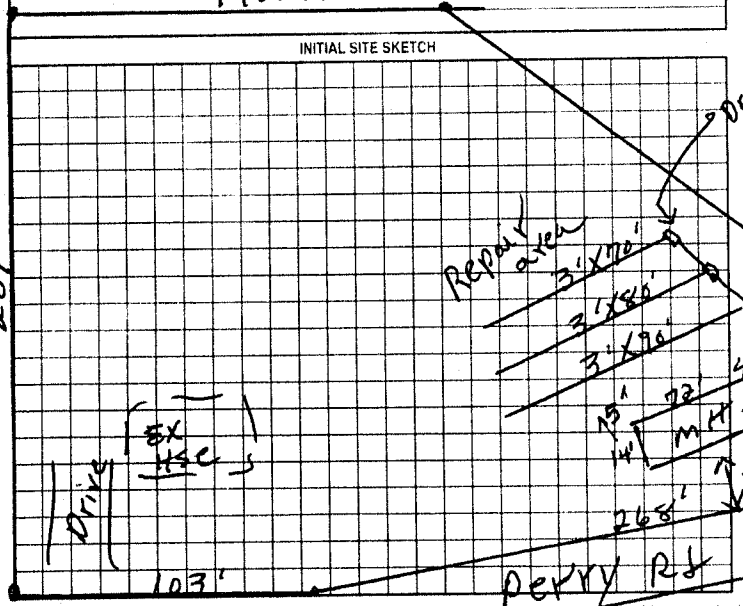

AS BUILT SKETCH

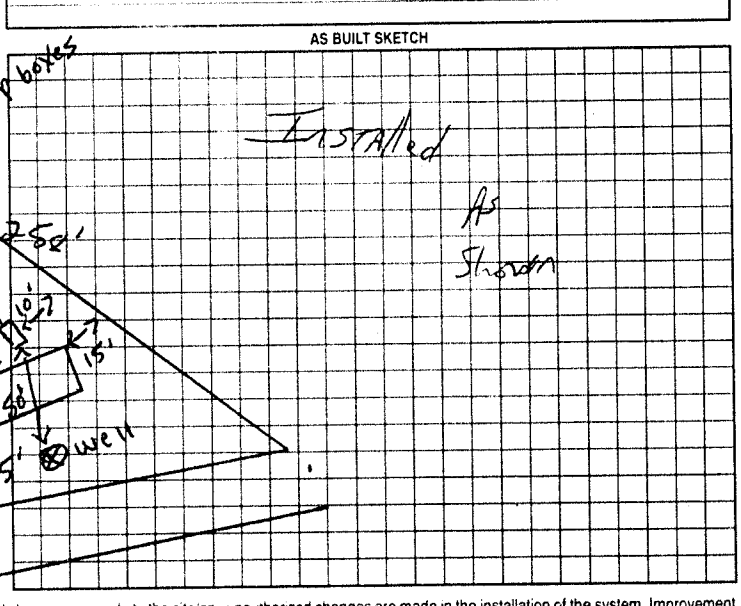

Permit can be suspended or revoked if any false information is supplied toward securing the permit/any unauthorized changes are made to the site/any unauthorized changes are made in the installation of the system. Improvement Permit with plat valid without expiration. Improvement Permit with site plan valid for sixty months. Authorization to Construct is valid for a period equal to that of Improvement Permit – not to exceed sixty months.

Signed: Millard Rydell Cowan date

Improvement Permit by: P.C. Moore date 9-21-99

Authorization to Construct by: P.C. Moore date 9-21-99

Installed by: G + M. Rothel date Feb 11. 2000

Operation Permit by: date

Existing System Inspection by: date

HEALTH DEPT. COPY. WHITE OWNER COPY (FINAL) YELLOW OWNER COPY (INITIAL) PINK