IREDELL COUNTY HEALTH DEPARTMENT

STATESVILLE 704-878-5305 MOORESVILLE 704-664-5281

IMPROVEMENT PERMIT / AUTHORIZATION TO CONSTRUCT / OPERATION PERMIT / EXISTING SYSTEM INSPECTION

PERMIT# REPAIR 100658 PIN# 4741-87-0243 DATE 11-27-06

OWNER OR CONTRACTOR MATTHEW K. CARTY PHONE: Business 704-252-0800 Home 704-528-9889

ADDRESS P.O. BOX 1075, TROUTMAN, NC 28166-8689

LOCATION MURDOCK ROAD to HOOVER ROAD, TL MARTHA'S VINEYARD, TR PAINTED BUNTING DRIVE 2ND TO LAST ON RIGHT

SUBDIVISION MARTHA'S VINEYARD BLOCK / SECTION ____ LOT 26 LOT AREA 0.69 ACRE SITE CLASS PS DESIGN FLOW 480 L.T.A.R. 0.30 GPD/FT² (EXISTING)

Septic Tank: EXISTING Gallons; STB ____ Date ____

Pump Tank: EXISTING Gallons; PT ____ Date ____

Pump Make: ____ Model ____ Serial No. ____

Nitrification Field: No Fields 1 Square Feet 60 TO 240 Linear Feet 40

No Lines ONE NEW Trench Width 24" Max Trench Bottom Depth 30" STONE Depth 24"

☐ New System ☑ Repair System Type: I, II, III, IV, V

System Description: 50% REDUCTION, LOW PRES.

Repair System Description: 50% REDUCTION

Maintenance Agreement Required: ☑ Yes ☐ No LOW-PRES

☑ House/Mod. Home No. Bedrooms 4

☐ Mobile Home No. Bathrooms ____

☐ Business No. Employees ____

☐ Other ____


☐ Slab ☑ Crawl Space ☐ Basement w/plumbing ☐ Basement wo/plumbing

Water Supply: ☐ Individual ☐ Public ☐ Community WELL


Comments:/Conditions: ① RELOCATE CENTRAL GATE VALVE BOX AS SHOWN ② INSTALL NEW 2"x40 PP&PS DRAIN LINE USING LOW PRESSURE DIST. (5/32" HOLES) ③ INSTALL SUBSURFACE INTERCEPT DRAINAGE DITCH AS SHOWN

Comments:/Conditions:

INITIAL SITE SKETCH

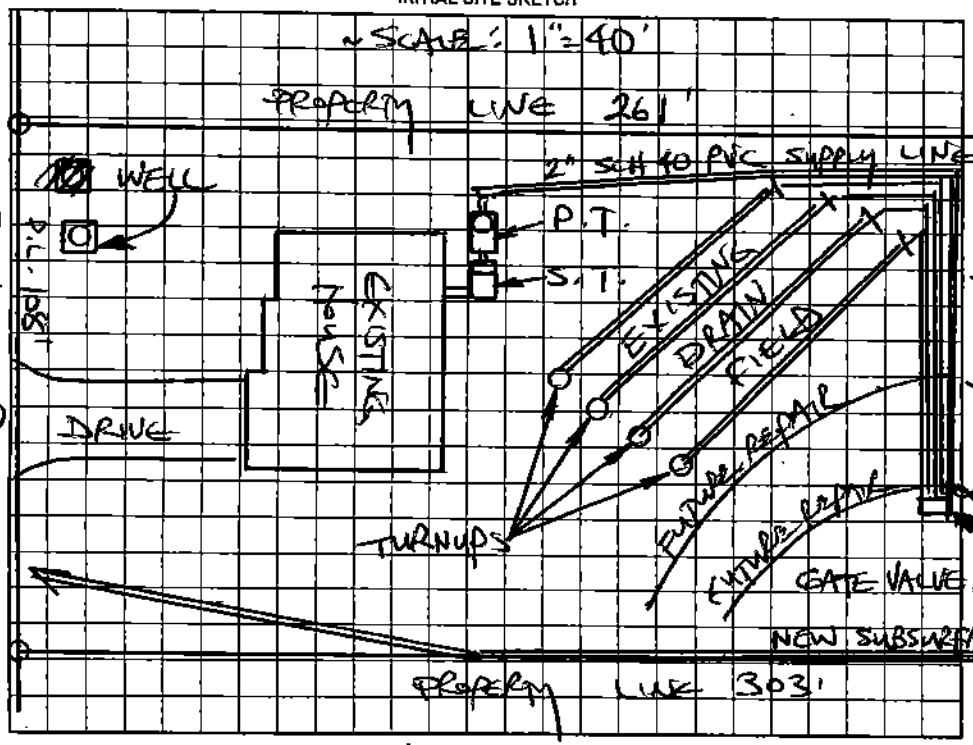

AS BUILT SKETCH

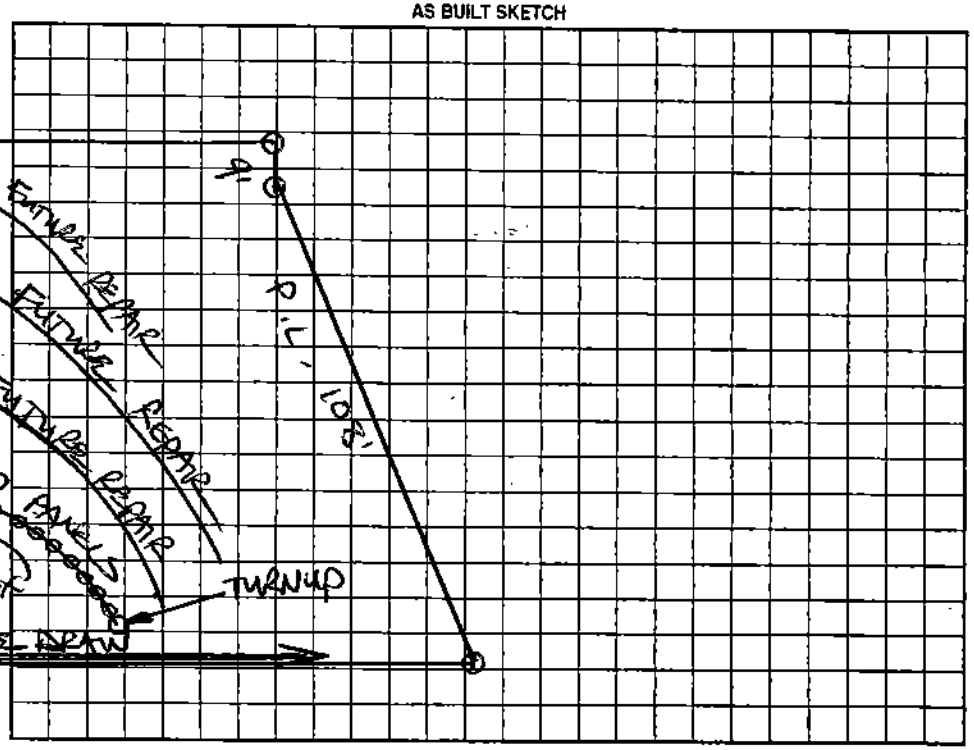

Permit can be suspended or revoked if any false information is supplied toward securing the permit/any unauthorized changes are made to the site/any unauthorized changes are made in the installation of the system. Improvement Permit with plat valid without expiration. Improvement Permit with site plan valid for sixty months. Authorization to Construct is valid for a period equal to that of Improvement Permit – not to exceed sixty months.

Signed: Matthew K. Carty date 11-27-06 Installed by: A-1 BACKHE

Improvement Permit by: STEVE HENDRICK date 11-27-06 Operation Permit by: STEVE HENDRICK date 12-13-06

Authorization to Construct by: STEVE HENDRICK date 11-27-06 Existing System Inspection by: ____ date ____

HEALTH DEPT. COPY: WHITE OWNER COPY (FINAL): YELLOW OWNER COPY (INITIAL): PINK