IREDELL COUNTY HEALTH DEPARTMENT

STATESVILLE 704-878-5305 MOORESVILLE 704-664-5281

IMPROVEMENT PERMIT / AUTHORIZATION TO CONSTRUCT / OPERATION PERMIT / EXISTING SYSTEM INSPECTION

PERMIT# 100658 PIN# 4741-57-0243 DATE 11-17-05

OWNER OR CONTRACTOR William Bywater PHONE: Business 704-895-0554 Home

ADDRESS Box 99 Davidson NC 28036

LOCATION 21 to Mudock to Hoover to Mayhaw Vineyard to Painted Bunting - Culdsac - R1

SUBDIVISION Mayhaw Vineyard BLOCK / SECTION LOT 26 LOT AREA .169 SITE CLASS. RS DESIGN FLOW 480 L.T.A.R. .13

Septic Tank: 1000 Gallons; STB 10/12 Date 5-27-05
Pump Tank: 1000 Gallons; PT 17 Date 11-1-05
Pump Make: Model Serial No.
Nitrification Field: No Fields Square Feet 534 Linear Feet 267
No Lines 4 Trench Width 24" Max Trench Bottom Depth 36" Gravel Depth

☑ New System ☐ Repair System Type: I, II, III, IV, V, VI
System Description: 2P Panel
Repair System Description: 2P Panel
Maintenance Agreement Required: ☑ Yes ☐ No


☑ House/Mod. Home No. Bedrooms 4
☐ Mobile Home No. Bathrooms
☐ Business No. Employees
☐ Other
☐ Slab ☑ Crawl Space ☐ Basement w/plumbing ☐ Basement wo/plumbing

Water Supply: ☑ Individual ☐ Public ☐ Community


Comments:/Conditions: Install on contour
Maintain all set backs

Comments:/Conditions:
* DO NOT Cut for positive drainage requirements keep Hanor out of ground and Backfill — If cut permit will be VOID

INITIAL SITE SKETCH

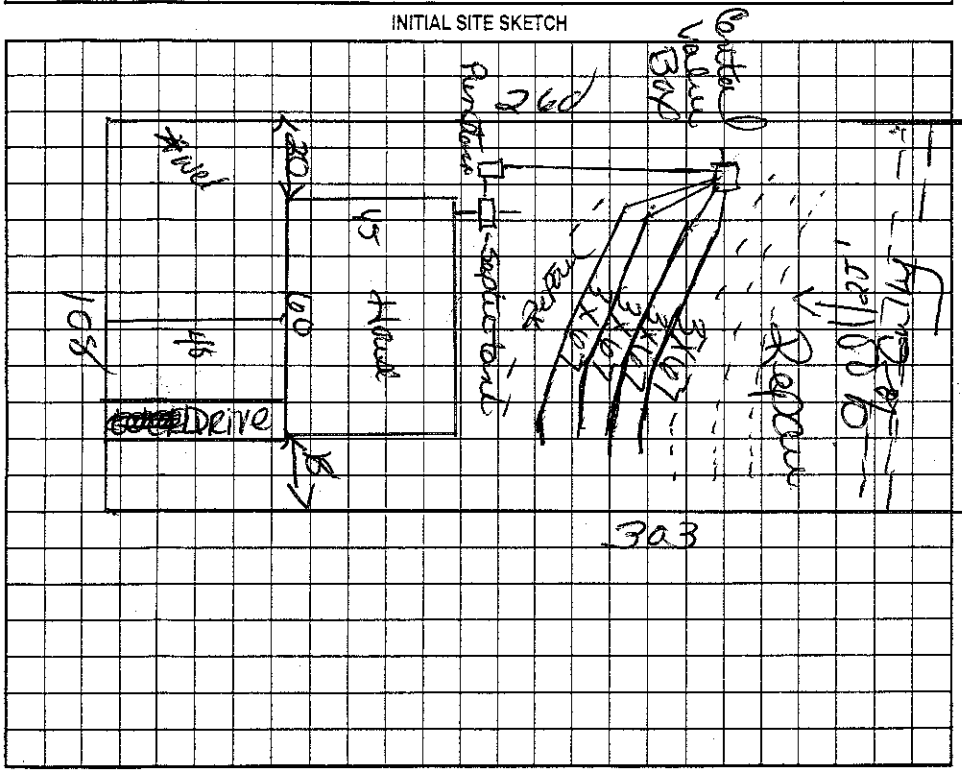

AS BUILT SKETCH

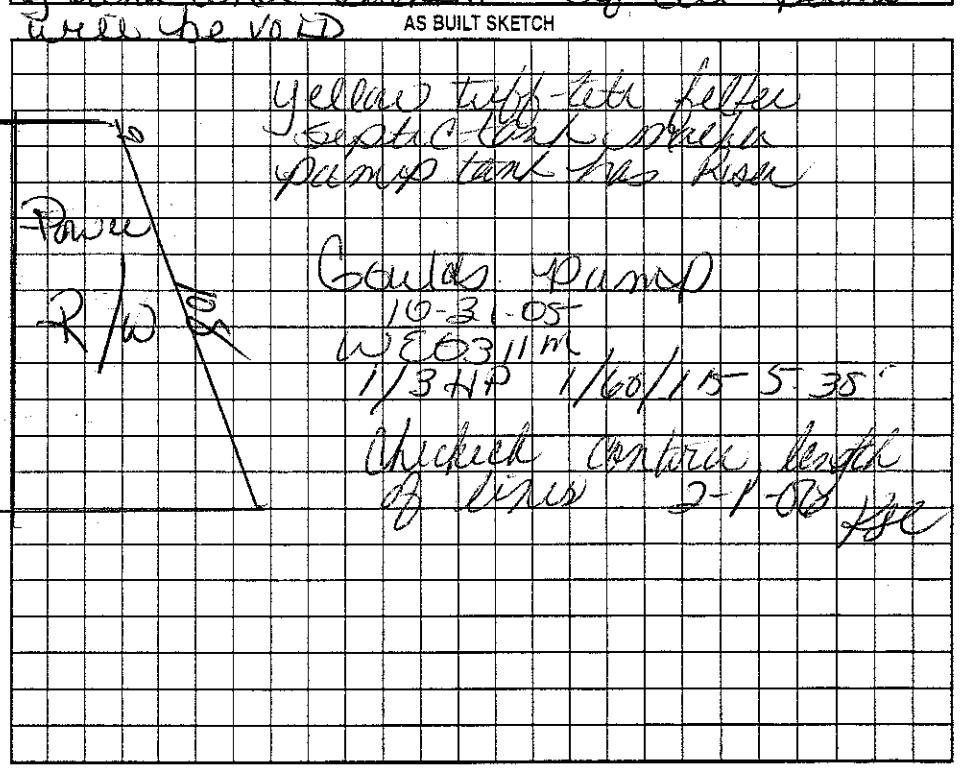

Permit can be suspended or revoked if any false information is supplied toward securing the permit/any unauthorized changes are made to the site/any unauthorized changes are made in the installation of the system. Improvement Permit with plat valid without expiration. Improvement Permit with site plan valid for sixty months. Authorization to Construct is valid for a period equal to that of Improvement Permit – not to exceed sixty months.

Signed: date 11-18-05 Installed by: H J Barlow

Improvement Permit by: Kelly Cook date 11-17-05 Operation Permit by: Kelly Cook date 5-23-06

Authorization to Construct by: Kelly Cook date 11-17-05 Existing System Inspection by: date

HEALTH DEPT. COPY: WHITE OWNER COPY (FINAL): YELLOW OWNER COPY (INITIAL): PINK