IREDELL COUNTY HEALTH DEPARTMENT

STATESVILLE 704-878-5305 MOORESVILLE 704-664-5281

IMPROVEMENT PERMIT / AUTHORIZATION TO CONSTRUCT / OPERATION PERMIT / EXISTING SYSTEM INSPECTION

PERMIT# ~~100647~~ 129423 PIN# ~~4744-78-8148-PT~~ 4744-87-1935 DATE 7/26/01

OWNER OR CONTRACTOR ~~WILLIAM BREWSTER~~ William Brewster PHONE: Business 895-0556 Home

ADDRESS PO Box 99 DAVIDSON NC 28036

LOCATION 215 - TL MURDOCK - TR HOOVER - TL MARTHAS VINEYARD - TR PAINTED BUNTING - ON LT

SUBDIVISION MARTHAS VINEYARD BLOCK / SECTION II LOT 16 LOT AREA .80 AC SITE CLASS. A/S DESIGN FLOW 360 GPD L.T.A.R. .36 GPD/FT²

Septic Tank: 1000 Gallons; STB 1017 Date 3-1-05

Pump Tank: Gallons; PT Date

Pump Make: Model Serial No.

Nitrification Field: No Fields 1 Square Feet 1080 Linear Feet 360

No Lines 4@90' Trench Width 36" Max Trench Bottom Depth 36" Gravel Depth N/A

☑ New System ☐ Repair System Type: I, II, III, IV, V, VI

System Description: GRAVITY 25% REDUCTION

Repair System Description: LP PANEL

Maintenance Agreement Required: ☐ Yes ☑ No

☑ House/Mod. Home No. Bedrooms 3

☐ Mobile Home No. Bathrooms 3

☐ Business No. Employees

☐ Other


☐ Slab ☑ Crawl Space ☐ Basement w/plumbing ☐ Basement wo/plumbing

Water Supply: ☑ Individual ☐ Public ☐ Community


Comments:/Conditions:

Comments:/Conditions: Approved 54' x 45' HOUSE PLAN 18' OFF LEFT P/L & 90' OFF FRONT P/L AS DRAWN. KEEP FILL TO TANK. TUFF TITE Filter & MARKER

INITIAL SITE SKETCH 1" = 50'

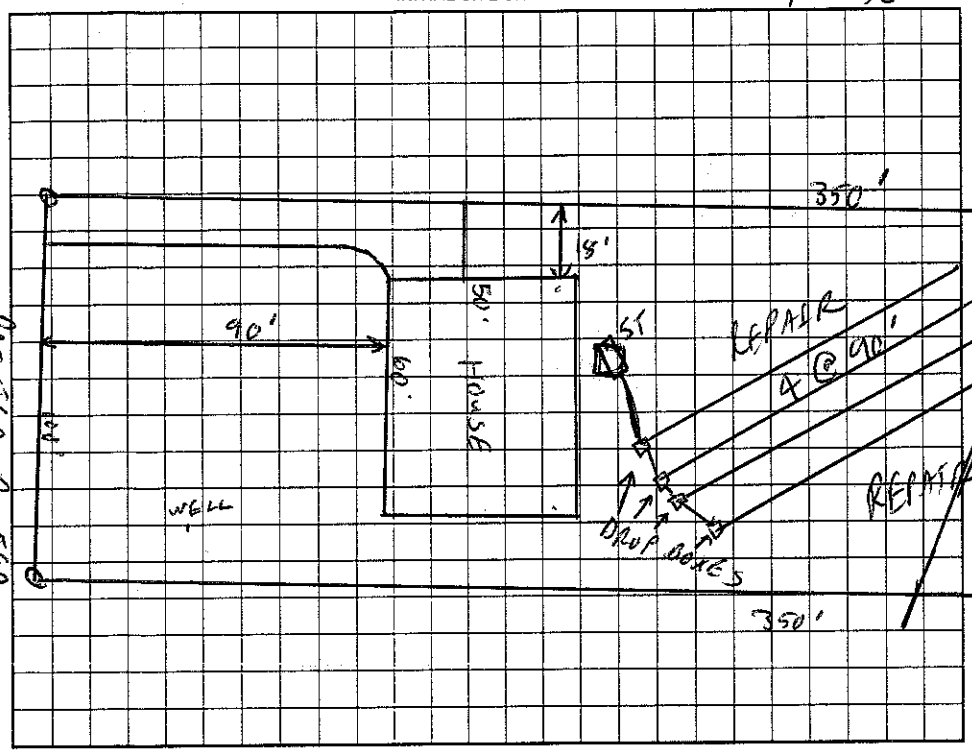

AS BUILT SKETCH

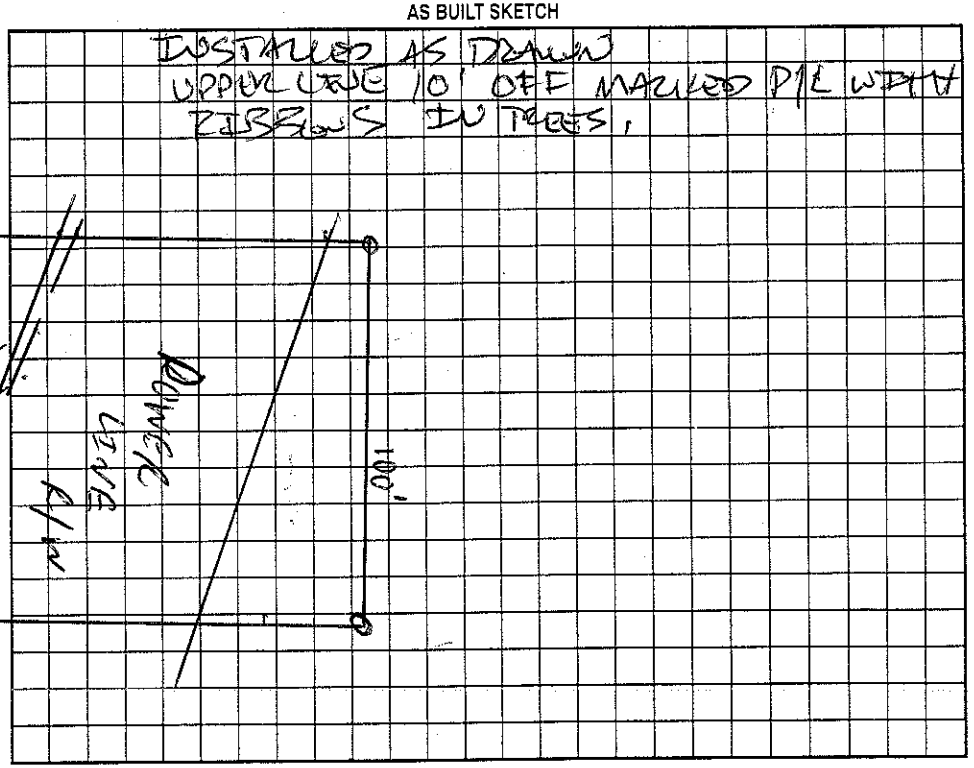

Permit can be suspended or revoked if any false information is supplied toward securing the permit/any unauthorized changes are made to the site/any unauthorized changes are made in the installation of the system. Improvement Permit with plat valid without expiration, Improvement Permit with site plan valid for sixty months. Authorization to Construct is valid for a period equal to that of Improvement Permit – not to exceed sixty months.

Signed: date 10/8/01

Improvement Permit by: CS date 7/26/01

Authorization to Construct by: date 6-13-05

Installed by: A-1 BACKHOE

Operation Permit by: date 8-26-05

Existing System Inspection by: date

HEALTH DEPT. COPY: WHITE OWNER COPY (FINAL): YELLOW OWNER COPY (INITIAL): PINK