122028

IREDELL COUNTY HEALTH DEPARTMENT

THIS PERMIT REPLACES PREVIOUS ISSUED 7-26-01

STATESVILLE 704-878-5305 @ MOORESVILLE 704-664-5281

IMPROVEMENT PERMIT / AUTHORIZATION TO CONSTRUCT / OPERATION PERMIT / EXISTING SYSTEM INSPECTION

PERMIT# 100654 122028 PIN# 4741-87-2648 DATE 6-9-04

OWNER OR CONTRACTOR WILLIAM BREWSTER PHONE: Business 704-895-0556 Home 704-400-5066

ADDRESS P.O. BOX 99, DAVIDSON NC 28036

LOCATION US 21 S, TL MURDOCK RD, TR HOOVER RD, TL MARTHA'S VINEYARD, TR PAINTED BUNTING DR, 12TH LOT ON LEFT

SUBDIVISION MARTHA'S VINEYARD BLOCK / SECTION 2 LOT 19 LOT AREA 0.803 ACRE SITE CLASS. PS DESIGN FLOW 600 L.T.A.R. 0.30 GPD/FT²

Septic Tank: 1500 Gallons; STB 1011 Date 6-19-04
Pump Tank: ____ Gallons; PT ____ Date ____
Pump Make: ____ Model ____ Serial No. ____
Nitrification Field: No Fields 1 Square Feet EST 2000 Linear Feet 500
No Lines SIX Trench Width 36" Max Trench Bottom Depth 36" Gravel Depth N/A

☑ New System ☐ Repair System Type: I, II, III, IV, V, VI
System Description: 25% REDUCTION, GRAVITY
Repair System Description: 50% REDUCTION LOW PRESSURE
Maintenance Agreement Required: ☐ Yes ☑ No
☐ Slab ☑ Crawl Space ☐ Basement w/plumbing ☐ Basement wo/plumbing


☑ House/Mod. Home No. Bedrooms 4
☐ Mobile Home No. Bathrooms 2.5
☐ Business No. Employees ____
☐ Other w/ BONUS ROOM

Water Supply: ☑ Individual ☐ Public ☐ Community
WELL


Comments/Conditions: INSTALL 25% REDUCTION SYSTEM ON CONTOUR AS SHOWN. USE ONE FLOW DIVIDER TEE TO ACHIEVE EQUAL DISTRIBUTION INTO TWO SUBFIELDS. KEEP WATER LINE MINIMUM 10' FROM SYSTEM

Comments/Conditions: SEPTIC TANK WITH MARKER INSTALLED USING "TUFTITE" FILTER

INITIAL SITE SKETCH

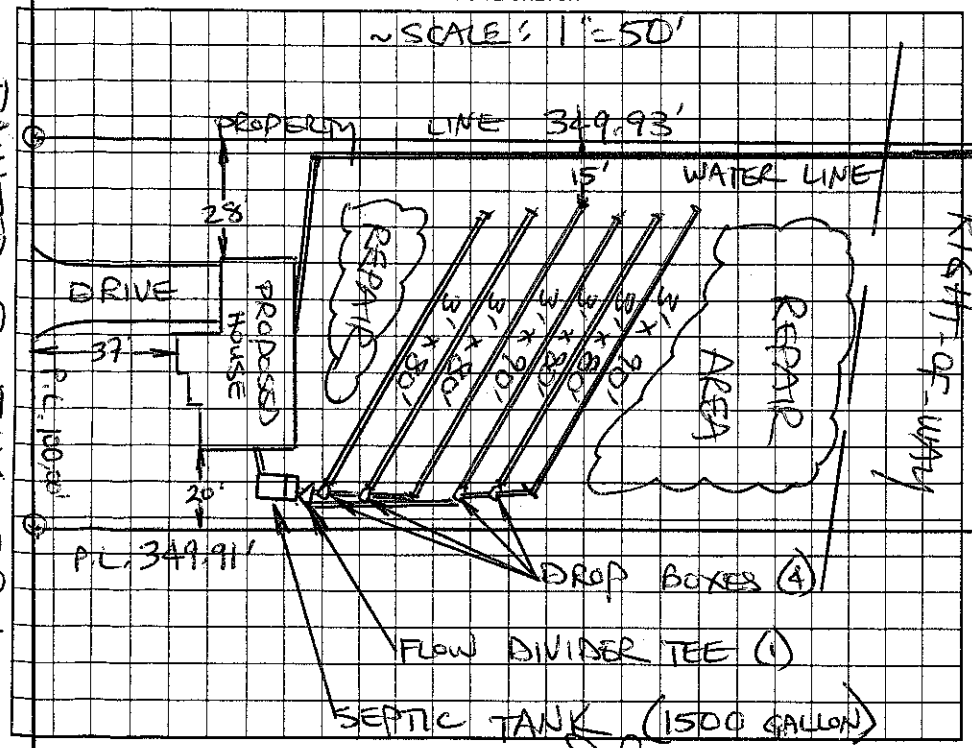

AS BUILT SKETCH

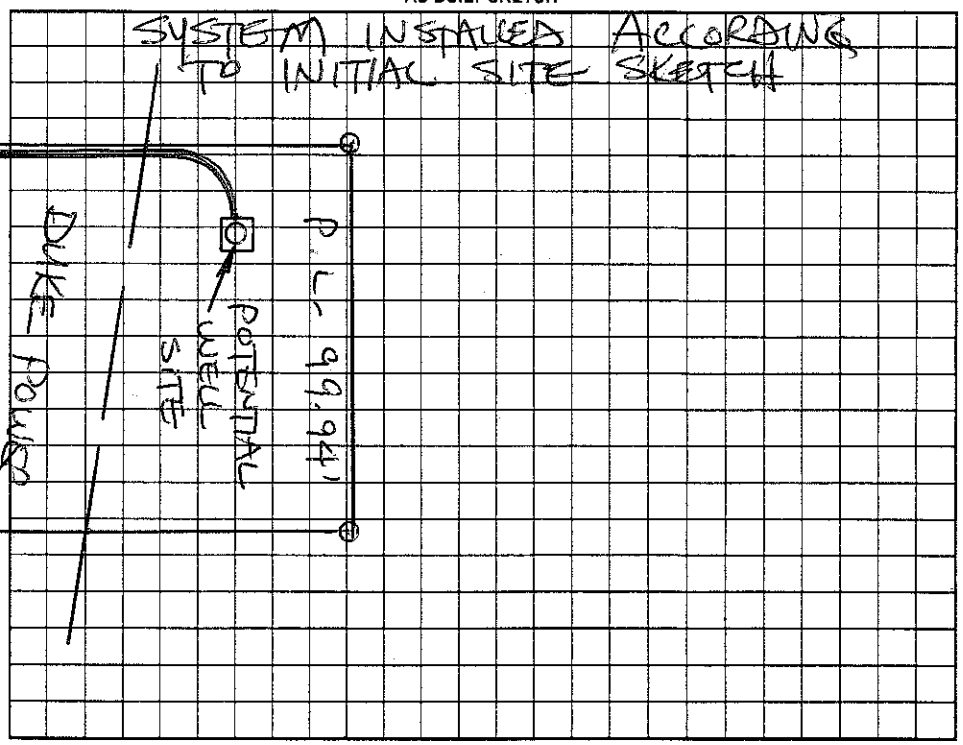

Permit can be suspended or revoked if any false information is supplied toward securing the permit/any unauthorized changes are made to the site/any unauthorized changes are made in the installation of the system. Improvement Permit with plat valid without expiration. Improvement Permit with site plan valid for sixty months. Authorization to Construct is valid for a period equal to that of Improvement Permit – not to exceed sixty months.

Signed: Angel Blount date 6/11/04 Installed by: A-1 BACKHOE

Improvement Permit by: STEVE HEDRICK date 6-9-04 Operation Permit by: STEVE HEDRICK date 9-23-04

Authorization to Construct by: STEVE HEDRICK date 6-9-04 Existing System Inspection by: ____ date ____

HEALTH DEPT. COPY: WHITE OWNER COPY (FINAL): YELLOW OWNER COPY (INITIAL): PINK