122030

IREDELL COUNTY HEALTH DEPARTMENT

THIS PERMIT REPLACES PREVIOUS ISSUED 7-26-01 (C1)

STATESVILLE 704-878-5305 MOORESVILLE 704-664-5281

IMPROVEMENT PERMIT / AUTHORIZATION TO CONSTRUCT / OPERATION PERMIT / EXISTING SYSTEM INSPECTION

PERMIT# 100649 | 122030 PIN# 4741-87-2717 DATE 6-9-04

OWNER OR CONTRACTOR WILLIAM BREWSTER PHONE: Business 704-895-0556 Home 704-400-5066 (DOUG JOHNSON)

ADDRESS P.O. BOX 99 DAVIDSON NC 28036

LOCATION US 21 S, TL MURDOCK RD, TR HOOVER RD, TL MARTHA'S VINEYARD, TR PAINTED BUNTING 1ST LOT ON LEFT

SUBDIVISION MARTHA'S VINEYARD BLOCK / SECTION 2 LOT 18 LOT AREA 0.803 ACRE SITE CLASS. PS DESIGN FLOW 480 L.T.A.R. 0.30 GPD/FT²

Septic Tank: 1000 Gallons; STB 1012 Date 5-10-04
Pump Tank: _____ Gallons; PT _____ Date _____
Pump Make: _____ Model _____ Serial No. _____
Nitrification Field: No Fields 1 Square Feet EQUIV 1600 Linear Feet 400
No Lines SIX Trench Width 36" Max Trench Bottom Depth 36" Gravel Depth N/A

☑ New System ☐ Repair System Type: I, II, III, IV, V, VI
System Description: 25% REDUCTION, GRAVITY
Repair System Description: 25% REDUCTION, GRAVITY
Maintenance Agreement Required: ☐ Yes ☑ No


☑ House/Mod. Home No. Bedrooms 4
☐ Mobile Home No. Bathrooms 2.5
☐ Business No. Employees ____
☐ Other _____
☐ Slab ☐ Crawl Space ☐ Basement w/plumbing ☐ Basement wo/plumbing

Water Supply: ☑ Individual ☐ Public ☐ Community
WELL


Comments:/Conditions: INSTALL 25% REDUCTION SYSTEM ON CONTOUR AS SHOWN. USE ONE FLOW DIVIDER TEE TO ACHIEVE EQUAL DISTRIBUTION INTO EACH SUBFIELD. LOCATE WELL AS SHOWN

Comments:/Conditions: KEEP WATER LINE MINIMUM 10' FROM SYSTEM
SEPTIC TANK WITH MARKER INSTALLED
USING "TUFTITE" FILTER

INITIAL SITE SKETCH

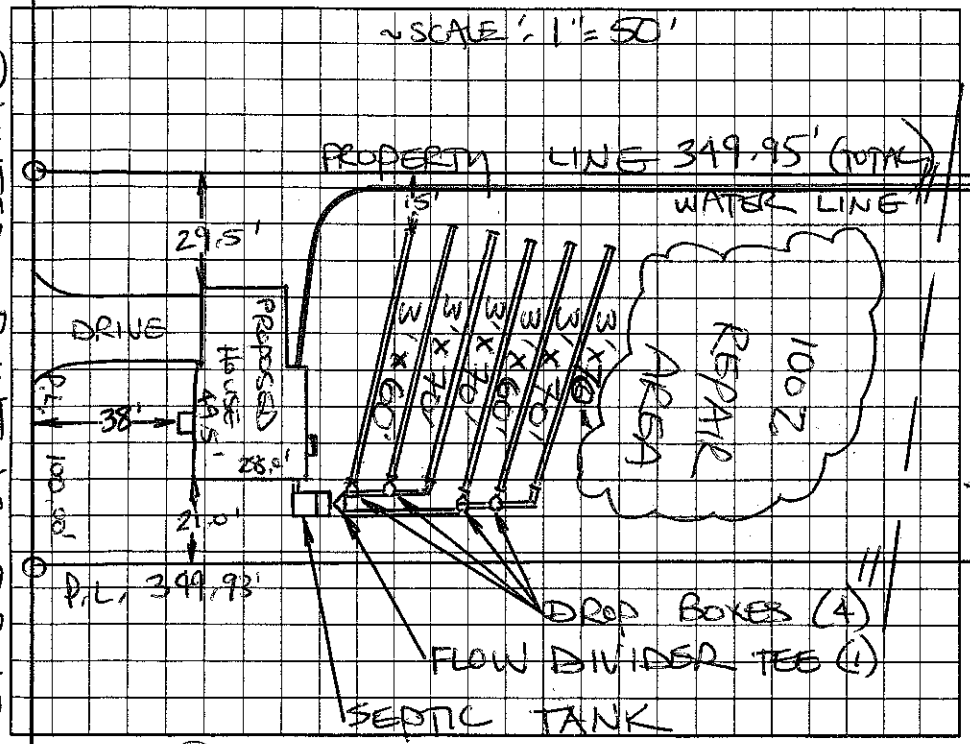

AS BUILT SKETCH

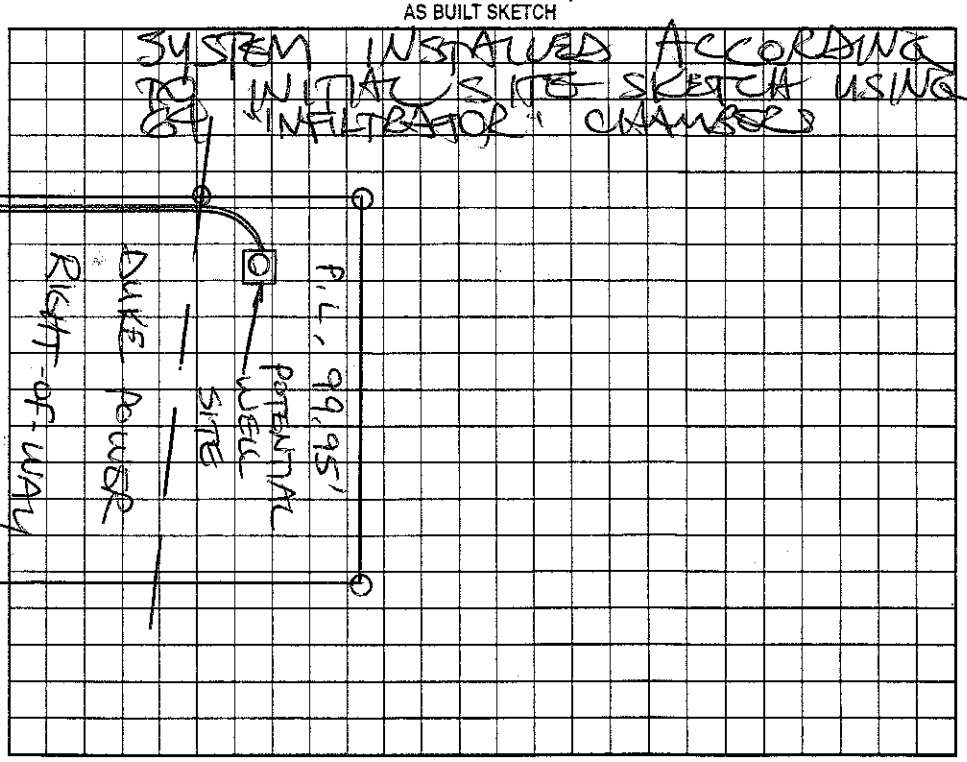

Permit can be suspended or revoked if any false information is supplied toward securing the permit/any unauthorized changes are made to the site/any unauthorized changes are made in the installation of the system. Improvement Permit with plat valid without expiration. Improvement Permit with site plan valid for sixty months. Authorization to Construct is valid for a period equal to that of Improvement Permit – not to exceed sixty months.

Signed: _____ date 6/11/04 Installed by: A-1 BACKHOE

Improvement Permit by: STEVE HENDRICK date 6-9-04 Operation Permit by: STEVE HENDRICK date 9-22-04

Authorization to Construct by: STEVE HENDRICK date 6-9-04 Existing System Inspection by: _____ date _____

HEALTH DEPT. COPY: WHITE OWNER COPY (FINAL): YELLOW OWNER COPY (INITIAL): PINK