IREDELL COUNTY HEALTH DEPARTMENT

STATESVILLE 704-878-5305 MOORESVILLE 704-664-5281

IMPROVEMENT PERMIT / AUTHORIZATION TO CONSTRUCT / OPERATION PERMIT / EXISTING SYSTEM INSPECTION

PERMIT# 100655 PIN# ~~4744-78-2448~~ 4744-89-4223 DATE 9-7-04

OWNER OR CONTRACTOR William BREWSTER PHONE: Business 895-0556 Home 704-400-5066

ADDRESS P.O. BOX 99 DAVIDSON, NC 28036

LOCATION 21 S (L) MADDOX RD (R) HOOVER (L) MARTHA STEPHENS (R) PAINTED BUNTING ATEND ON LEFT

SUBDIVISION MARTHA STEPHENS BLOCK / SECTION ____ LOT 23 LOT AREA 2.105 AC SITE CLASS. PS DESIGN FLOW 420 L.T.A.R. .35

Septic Tank: 1000 Gallons: STB 1000 Date 5-01-04
Pump Tank: 1000 Gallons: PT ____ Date 6-16-04
Pump Make: GOULDS Model WE0111H Serial No. S05401328
Nitrification Field: No Fields 1 Square Feet 1371 Linear Feet 232'
No Lines 4x58' Trench Width 24" Max Trench Bottom Depth 36" Gravel Depth N/A

☒ New System ☐ Repair System Type: I, II, III, (IV), V, VI
System Description: LOW PRESS 50% RED
Repair System Description: LPP
Maintenance Agreement Required: ☒ Yes ☐ No

☒ House/Mod. Home No. Bedrooms 4
☐ Mobile Home No. Bathrooms 2.5
☐ Business No. Employees ____
☐ Other ____
☐ Slab ☒ Crawl Space ☐ Basement w/plumbing ☐ Basement wo/plumbing


Water Supply: ☒ Individual ☐ Public ☐ Community

Comments/Conditions: * BUILDER OK'D TANK & SYSTEM LOCATIONS


Comments/Conditions: (1) THIS IS A REDRAW PERMIT, ONLY CHANGES WERE SYSTEM TYPE & BEDROOMS, PERMIT REDRAWN USING CRITERIA FROM PREVIOUS ISSUED PERMIT ISSUED BY BRADY FREEMAN, R.S. ON 10-5-01; SYSTEM WILL BE INSTALLED IN SAME LOCATION

PROPOSED SPECIALIST

INITIAL SITE SKETCH

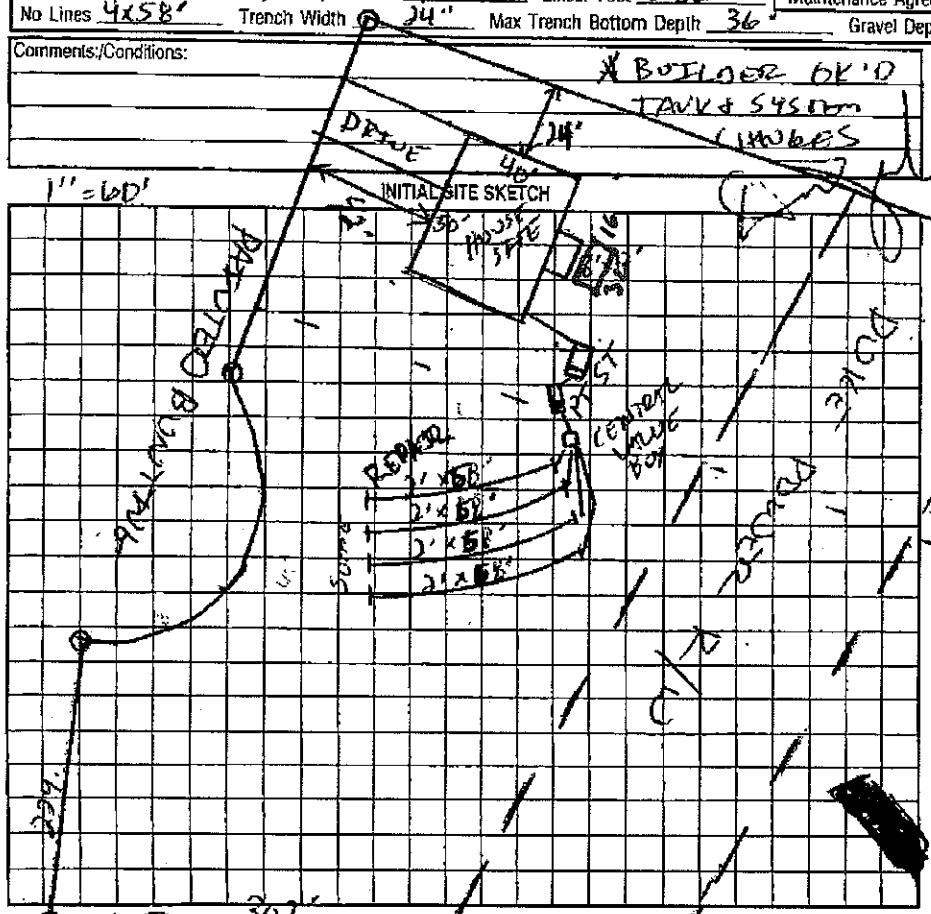

AS BUILT SKETCH

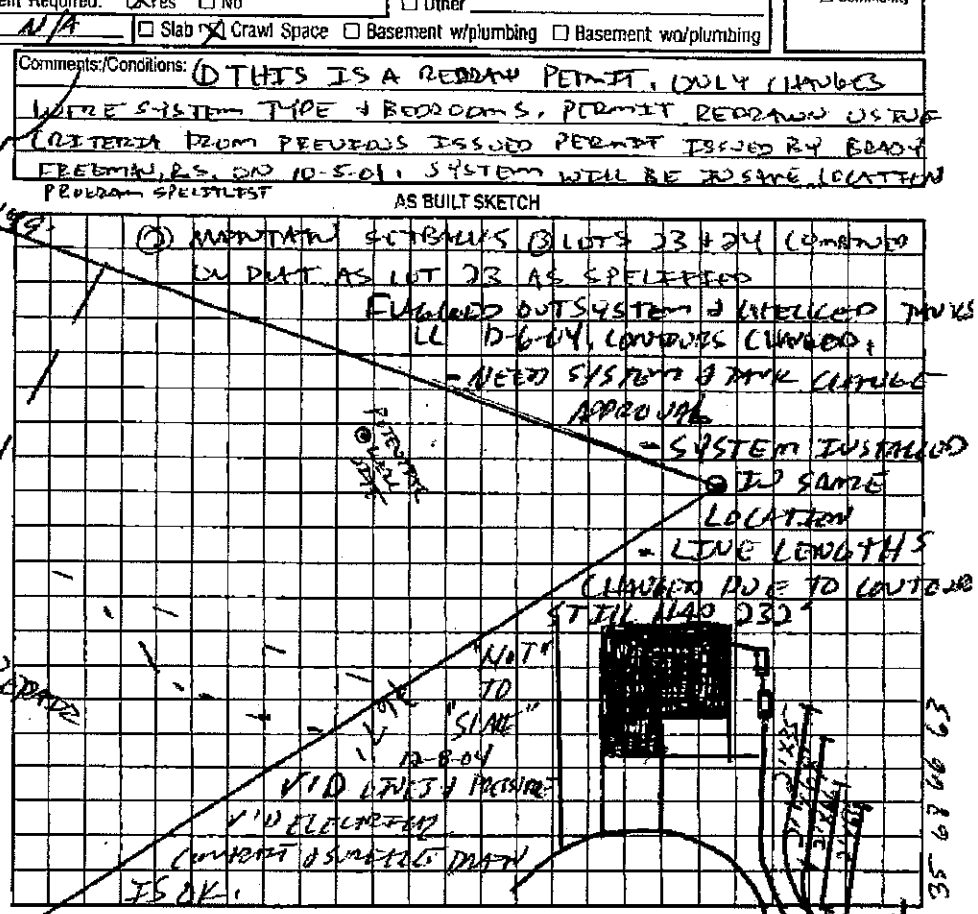

Permit can be suspended or revoked if any false information is supplied toward securing the permit/any unauthorized changes are made to the site/any unauthorized changes are made in the installation of the system. Improvement Permit with plat valid without expiration. Improvement Permit with site plan valid for sixty months. Authorization to Construct is valid for a period equal to that of Improvement Permit – not to exceed sixty months.

Signed: [signature] date 9/8/04 Installed by: A-1 BACKHOE

Improvement Permit by: [signature] date 9-7-04 Operation Permit by: ____

[signature] date 9-7-04 Existing System Inspect

Location of the proposed 16'x32' inground pool addition does not appear to impact the existing on-site septic system.**NOTE:

[signature] REHS

Date: 11-1-11

ICHD-Environmental Health Division

HEALTH DEPT. COPY: WHITE OWNER COPY (FINAL): YELLOW OWNER