IREDELL COUNTY HEALTH DEPARTMENT

STATESVILLE 704-878-5305 MOORESVILLE 704-664-5281

IMPROVEMENT PERMIT / AUTHORIZATION TO CONSTRUCT / OPERATION PERMIT / EXISTING SYSTEM INSPECTION

PERMIT# 100655 PIN# ~~4744-78-2148~~ 4741-87-4223 DATE 9-7-04

OWNER OR CONTRACTOR William BREWSTER PHONE: Business 878-0556 Home 704-400-5066

ADDRESS P.O. Box 99 DAVIDSON, NC 28036

LOCATION 21 S (L) MURDOCK (R) HOOVER (L) MARTHA VINEYARD (R) PAINTED BUNTING AT END ON LEFT

SUBDIVISION MARTHA VINEYARD BLOCK / SECTION ____ LOT 23 LOT AREA 2.105 AC SITE CLASS. PS DESIGN FLOW 420 L.T.A.R. .35

Septic Tank: 1000 Gallons; STB 0042 Date 5-01-04

Pump Tank: 1000 Gallons; PT 99 Date 6-16-04

Pump Make: Goulds Model WE0111H Serial No. 505401828

Nitrification Field: No Fields 1 Square Feet 1371 Linear Feet 232'

No Lines 4x58' Trench Width 24" Max Trench Bottom Depth 36" Gravel Depth N/A

☒ New System ☐ Repair System Type: I, II, III, (IV), V, VI

System Description: LOW PRESS 50'/1200

Repair System Description: LPP

Maintenance Agreement Required: ☒ Yes ☐ No

☒ House/Mod. Home No. Bedrooms 4

☐ Mobile Home No. Bathrooms 2.5

☐ Business No. Employees ____

☐ Other ____

☐ Slab ☒ Crawl Space ☐ Basement w/plumbing ☐ Basement wo/plumbing

Water Supply: ☒ Individual ☐ Public ☐ Community

Comments:/Conditions:


* BUILDER OK'D TANK & SYSTEM CHANGES

Comments:/Conditions: (1) THIS IS A REDRAW PERMIT, ONLY CHANGES WERE SYSTEM TYPE & BEDROOMS, PERMIT REDRAWN USING CRITERIA FROM PREVIOUS ISSUED PERMIT ISSUED BY BRADY FREEMAN, R.S. ON 10-5-01; SYSTEM WILL BE IN SAME LOCATION

PROGRAM SPECIALIST

1" = 60'

INITIAL SITE SKETCH

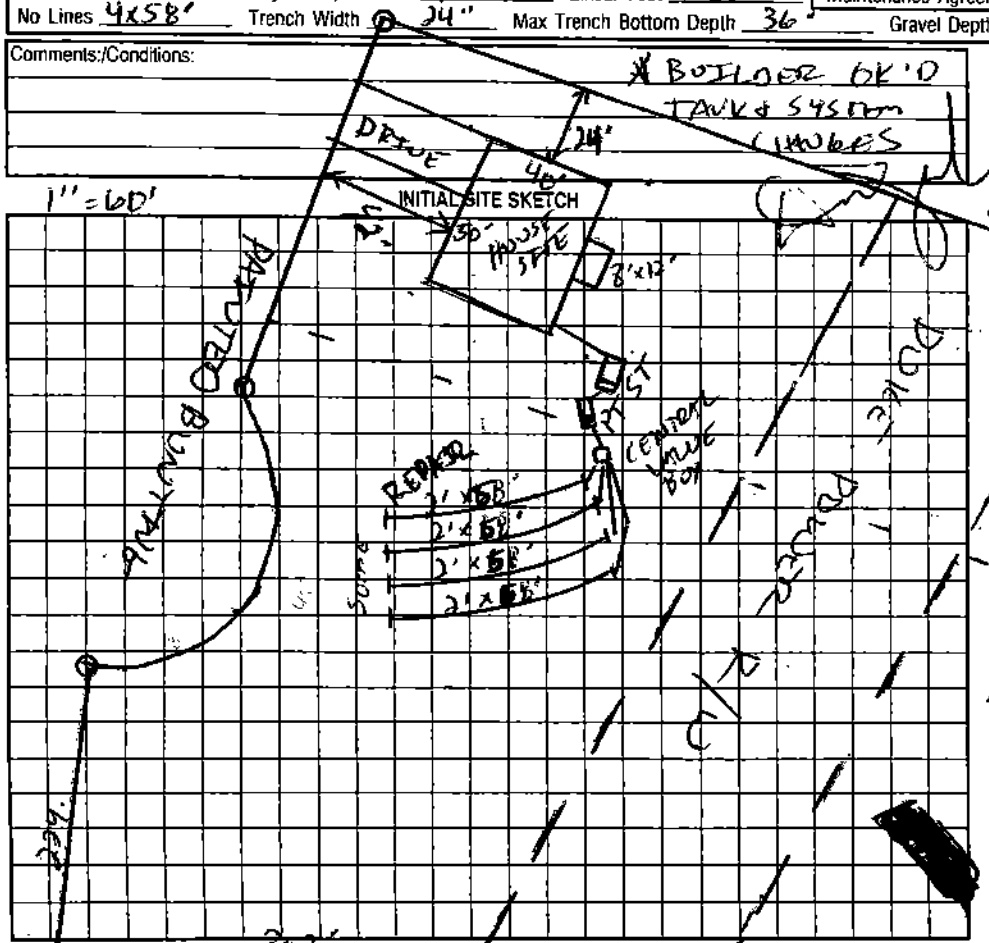


AS BUILT SKETCH

(2) MOUNTAIN SETBACKS (3) LOTS 23 & 24 COMBINED ON PLAT AS LOT 23 AS SPECIFIED

FLAGGED OUT SYSTEM & MARKED TANKS

LL 10-6-04, CONDITIONS CHANGED;

- NEED SYSTEM & TANK CHANGE APPROVAL
- SYSTEM INSTALLED IN SAME LOCATION
- LINE LENGTHS CHANGED DUE TO CONTOURS STILL HAD 232'

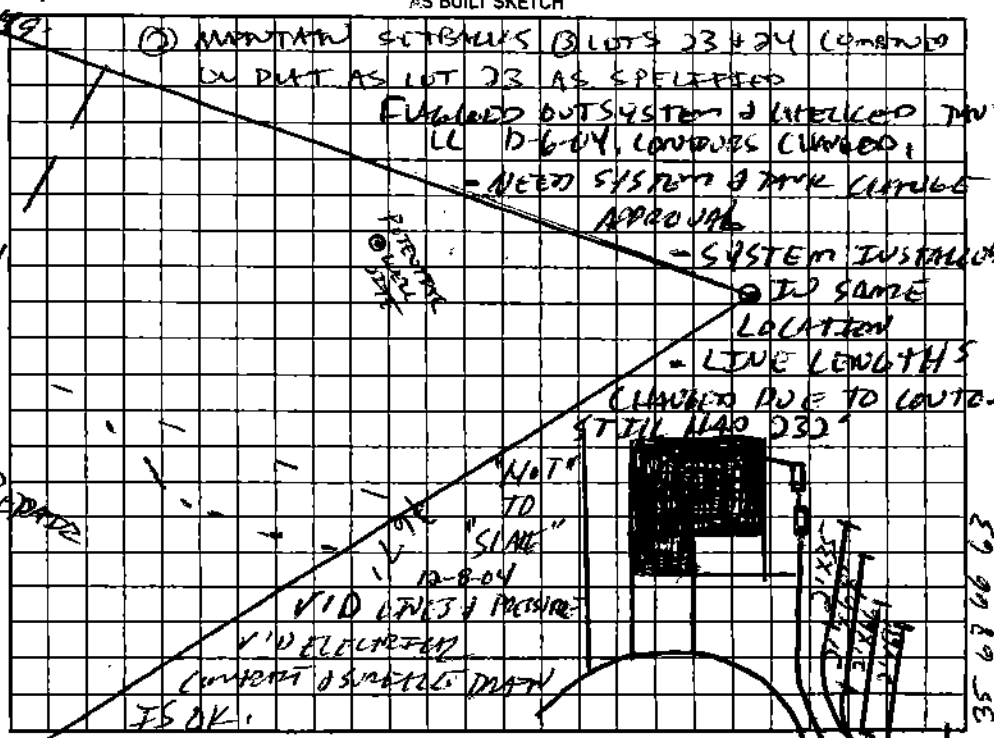

10-8-04 VID LINES & PRESSURE V'D ELEVATION COMPOST DISPOSAL PLAN IS OK.

Permit can be suspended or revoked if any false information is supplied toward securing the permit/any unauthorized changes are made to the site/any unauthorized changes are made in the installation of the system. Improvement Permit with plat valid without expiration. Improvement Permit with site plan valid for sixty months. Authorization to Construct is valid for a period equal to that of Improvement Permit – not to exceed sixty months.

Signed: [signature] date 9/8/04 Installed by: A-1 BACKHOE

Improvement Permit by: [signature] date 9-7-04 Operation Permit by: [signature] date 12-16-04

[signature] date 9-7-04 Existing System Inspection by: ____ date ____

HEALTH DEPT. COPY: WHITE OWNER COPY (FINAL): YELLOW OWNER COPY (INITIAL): PINK